


WELL PLUGGING RECORD

Give All Information Completely
Make Required Affidavit
Mail or Deliver Report to:
Conservation Division
State Corporation Commission
800 Bittling Building
Wichita, Kansas

Locs _____ County. Sec. 29 Twp. 25 Rge. 18 (E) _____ (W)
Location as "NE/CNW/SW" or footage from lines SE/4 NW/4 NE/4
Lease Owner Heathman-Seeligson Drilling Co.
Lease Name HOWLAND Well No. 2
Office Address 254 No. Washington, Wichita 7, Kansas
Character of Well (completed as Oil, Gas or Dry Hole) dry hole
Date well completed 7-29-1954
Application for plugging filed 7-29-54 19
Application for plugging approved 7-29-54 19
Plugging commenced 7-29-54 19
Plugging completed 7-29-54 19
Reason for abandonment of well or producing formation _____

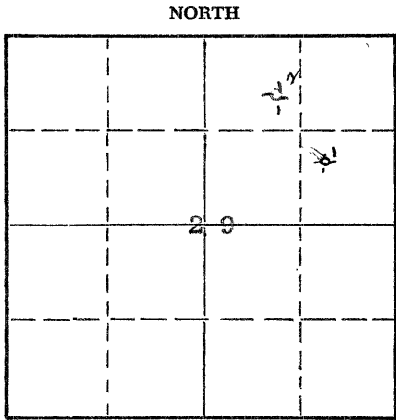

Locate well correctly on above Section Plat

If a producing well is abandoned, date of last production _____ 19____
Was permission obtained from the Conservation Division or its agents before plugging was commenced? yes

Name of Conservation Agent who supervised plugging of this well Eldon Petty, Box 326, Hays, Kansas
Producing formation _____ Depth to top _____ Bottom _____ Total Depth of Well 3024 Feet
Show depth and thickness of all water, oil and gas formations.

OIL, GAS OR WATER RECORDS

CASING RECORD

FORMATION	CONTENT	FROM	TO	SIZE	PUT IN	PULLED OUT
none				3-5/8" 22.7# Sprlvld.		
				surf. cement at 140'		
				w/105 sack. & 1 CC		none pulled.
				no-oil string		

Describe in detail the manner in which the well was plugged, indicating where the mud fluid was placed and the method or methods used in introducing it into the hole. If cement or other plugs were used, state the character of same and depth placed, from _____ feet to _____ feet for each plug set.

Filled hole to 150' w/heavy mud; set plug " 150' w/1/2 sack hulls and 15 sack. cement; set top plug " 40' w/1/2 sack hulls and 10 sacks cement.

RECEIVED
STATE CORPORATION COMMISSION
8/6/54
AUG 5 - 1954
CONSERVATION DIVISION
Wichita, Kansas

(If additional description is necessary, use BACK of this sheet)

Name of Plugging Contractor Heathman-Seeligson Drilling Co.
Address 254 No. Washington, Wichita 7, Kansas

STATE OF Kansas, COUNTY OF Sedgwick, ss.

W. M. Brodbeck (employee of owner) or (owner or operator) of the above-described well, being first duly sworn on oath, says: That I have knowledge of the facts, statements, and matters herein contained and the log of the above-described well as filed and that the same are true and correct. So help me God. HEATHMAN-SEELIGSON DRILLING CO.

(Signature) By: W. M. Brodbeck
254 No. Washington, Wichita 7, Kansas
(Address)

SUBSCRIBED AND SWORN TO before me this 2nd day of August, 19 54

My commission expires July 22, 1956

D. Marjorie Mott
Notary Public.

PLUGGING
FILE SEC 29 T 9 R 18 W
BOOK PAGE 53 LINE 4

15-163-00709-02-00

DRILLERS' LOG

NAME:	KOEHLER #2	DATE SPUDDED:	7-19-54
LOCATION:	SE/4 NW/4 NE/4 Sec.29-9S-18W Rooks County, Kansas	ROTARY COMPLETION:	7-29-54
OPERATOR:	Heathman-Seeligson Drilling Co.	ELEVATION:	2171 DF 2169 Gr 2174 KB
CONTRACTOR:	Heathman-Seeligson Drilling Co.	Rotary TOTAL DEPTH:	3624'
SURFACE CASING:	8-5/8" (4 jts.) Spiralweld cemented at 140' w/105 sacks cement and 1 sack Calcium Chloride.. Cement circulated.		
OIL STRING:	None run - Dry and abandoned 7-29-54		

GEOLOGICAL TOPS (KB)

Anhydrite	1537 (≠ 637)
Topeka	3103 (- 929)
Heebner	3316 (-1142)
Toronto	3337 (-1162)
Lansing-Kansas City	3357 (-1183)
Arbuckle	3599 (-1425)
R.T.D.	3624 (-1450)

L O G

(Figures indicate bottom of formation)

Sand and shale	0 to 70
Blue Shale	140
Shale, shells and sand	390
Shale and shells	830
Sand	975
Shale and sand	1290
Shale and xxxx shells	1340
Shale and redbed	1537
Anhydrite	1550
Anhydrite	1575
Shale and shells	1790
Shale and shells	2015
Shale and shells	2135
Shale and lime	2960
Lime	2515
Shale and lime	3335
Lime	3365
Lime and shale	3405
Lime	3624
R.T.D.	3624'

RECEIVED
8/6/54
COMMISSION

The undersigned, Wm. M. BRODRICK, hereby certifies that the above log is a true and correct log of the formations encountered in drilling the above noted well as reflected by the Daily Drilling Reports.

HEATHMAN-SEELIGSON DRILLING CO.

By: *Wm. M. Brodrick*

Subscribed and sworn to before me, this 2nd day of August, 1954.

D. Marjorie West
Notary Public

My commission expires: June 28, 1956.

PLUGGING
FILE SEC 29 T 9 S 18W
BOOK PAGE 53 LINE 4