


STATE OF KANSAS
STATE CORPORATION COMMISSION
Give All Information Completely
Make Required Affidavit
Mail or Deliver Report to:
Conservation Division
State Corporation Commission
800 Bittling Building
Wichita, Kansas

WELL PLUGGING RECORD

Rooks County. Sec. 29 Twp. 9S Rge. 18 (E) (W)
Location as "NE/CNW/SW" or footage from lines NW SE NE
Lease Owner Heathman-Seeligson Drilling Co.
Lease Name KOEHLER Well No. 1
Office Address 251 No. Washington, Wichita 7, Kansas
Character of Well (completed as Oil, Gas or Dry Hole) dry hole
Date well completed 11-13-53
Application for plugging filed 11-17-53
Application for plugging approved 19
Plugging commenced December 3 19 53
Plugging completed December 7 19 53
Reason for abandonment of well or producing formation dry hole

NORTH

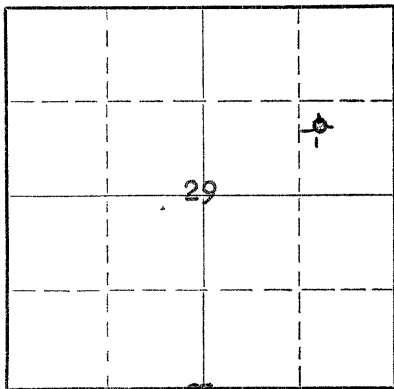

Locate well correctly on above
Section Plat

If a producing well is abandoned, date of last production ----- 19
Was permission obtained from the Conservation Division or its agents before plugging was commenced? yes

Name of Conservation Agent who supervised plugging of this well Eldon Petty, Box 326, Hays, Kansas
Producing formation ----- Depth to top ----- Bottom ----- Total Depth of Well 3641 Feet
Show depth and thickness of all water, oil and gas formations.

OIL, GAS OR WATER RECORDS

CASING RECORD

FORMATION	CONTENT	FROM	TO	SIZE	PUT IN	PULLED OUT
none				8-5/8"	188'	none
				cemented w/125 sax. & 1 sax.		Gal. Chlor.
				5-1/2"	3616'	3300'
				cemented w/50 sax.		

Describe in detail the manner in which the well was plugged, indicating where the mud fluid was placed and the method or methods used in introducing it into the hole. If cement or other plugs were used, state the character of same and depth placed, from ----- feet to ----- feet for each plug set.

Filled hole with sand from 3641' to 3610'
and ran 4 sacks of cement on top of sand.
Filled with mud from top of cement at
3590' to 188'. Set a rock bridge from 188'
to 175' and ran 15 sacks of cement at 175'.
Cement filled to 130'. Mudded hole from
130' to 35', set a 10' rock bridge and ran
10 sacks of cement to fill to top. Plugging
completed.

(If additional description is necessary, use BACK of this sheet)

Name of Plugging Contractor West Supply Co.
Address Chase, Kansas

STATE OF Kansas, COUNTY OF Sedgwick, ss.
H. D. Shreve (employee of owner) or (owner or operator) of the above-described
well, being first duly sworn on oath, says: That I have knowledge of the facts, statements, and matters herein contained and the log of the
above-described well as filed and that the same are true and correct. So help me God.
(Signature) H. D. Shreve


(Address)

SUBSCRIBED AND SWORN to before me this 18th day of December, 19 53

My commission expires June 28, 1956

10. Mary Jane Mott

Notary Public.

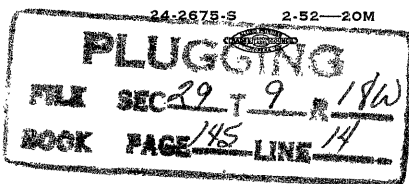

Received 12/19/53

Copy Comm

DRILLERS' LOG

NAME: KOEHLER # 1
 LOCATION: NW/4 SE/4 NE/4 Sec. 29-9S-18W
 Rocks County, Kansas
 OPERATOR: Heathman-Seeligson Drilling Co.
 CONTRACTOR: Heathman-Seeligson Drilling Co.
 SURFACE CASING: 8-5/8" (6 jts.) 8-Thd. Smls.
 2 1/2# new cement @ 188' w/125
 sacks cement - 1 Sack Cal. Chlor.
 Cement circulated
 OIL STRING: 5-1/2" (97 jts.) 1 1/2" H-10 Smls.
 8 Rd. cemented @ 3616' w/50 sacks.

DATE SPUDDED: 10-24-53
 ROTARY COMPLETION: 11-4-53
 ELEVATION: 2169' Gr
 2172' DF
 2175' KB
 ROTARY T.D.: 3617'

GEOLOGICAL TOPS

Anhydrite	1514 (+ 661)	Lansing-K. C.	3360 (-1185)
Topeka	3105 (- 930)	Arbuckle	3603 (-1428)
Heebner	3319 (-1144)	R.T.D.	3617'
Toronto	3340 (-1165)		

LOG

(Figures indicate bottom of formation)

Surface hole	0 to 192'
Shale and shells	345
Shale	1020
Sand	1260
Lime, shells and shale	1457
Shale and shells	1514
Shale - Anhydrite	1555
Shale and shells	1830
Salt	1970
Lime and shale	2175
Shale and sandy lime	2350
Lime and shale	2700
Lime	2740
Lime and shale	3105
Lime	3319
Shale	3323
Lime and shale	3364
Lime	3602
Lime and shale	3603
Arbuckle	3610
T.D.	3617'

The undersigned, H. D. SHREVE, hereby certifies that the above log is a true and correct log of the formations encountered in drilling the above noted well as reflected by the Daily Drilling Reports.

HEATHMAN-SEELIGSON DRILLING CO.

By: 

Subscribed and sworn to before me
 this 18th day of November, 1953.

D. Mayone Mott
 Notary Public

My commission expires: June 28, 1956.

Received
 12/19/53

