

CARD MUST BE TYPED

State of Kansas

CARD MUST BE SIGNED

### NOTICE OF INTENTION TO DRILL

(see rules on reverse side)

Starting Date January 31, 1987  
month day year

API Number 15— 037-21,395-00-00

OPERATOR: License # 07058

C NW SW Sec. 22 Twp. 28 S, Rg. 22 X East  
\_\_\_\_\_ West

Name Donald D. Ash Oil/Gas Production

1 980 Ft. from South Line of Section

Address R.R. 4-Box 65F

4 620 Ft. from East Line of Section

City/State/Zip Augusta, Ks. 67010

(Note: Locate well on Section Plat on reverse side)

Contact Person Donald D. Ash

Nearest lease or unit boundary line 660 feet

Phone (316) 775-3505

County Crawford

CONTRACTOR: License # 5419

Lease Name Ann Mein Well # 1

Name J-J Drilling Co. Inc.

Ground surface elevation unknown feet MSL

City/State Erie, Ks. 66733

Domestic well within 330 feet: no X no

Well Drilled For: Well Class: Type Equipment:

Municipal well within one mile: no X no

X Oil SWD Infield X Mud Rotary

Depth to bottom of fresh water none

Gas Inj X Pool Ext. Air Rotary

Depth to bottom of usable water 100 ft.

OWWO Expl Wildcat Cable

Surface pipe by Alternate: 1 2 X

If OWWO: old well info as follows:

Surface pipe planned to be set 20 ft.

Operator

Conductor pipe required none

Well Name

Projected Total Depth 400 feet

Comp Date Old Total Depth

Formation Bartlesville Sand

I certify that well will comply with K.S.A. 55-101, et seq., plus eventually plugging hole to KCC specifications.

Date 1-9-87 Signature of Operator or Agent Donald D. Ash Title Owner

For KCC Use:

Conductor Pipe Required \_\_\_\_\_ feet; Minimum Surface Pipe Required 20 feet per Alt. 402

This Authorization Expires 2-14-87 Approved By \_\_\_\_\_ 1-14-87


*[Handwritten signature]*

Must be filed with the K.C.C. five (5) days prior to commencing well  
This card void if drilling not started within six (6) months of date received by K.C.C.

**Important procedures to follow:**

1. Notify District office before setting surface casing.
2. Set surface casing by circulating cement to the top.
3. File completion forms ACO-1 with K.C.C. within 90 days of well completion, following instructions on ACO-1, side 1, and including copies of wireline logs.
4. Notify District office 48 hours prior to old well workover or re-entry.
5. Prior to filing Intent, prepare a proposed plugging plan in case well is D & A, then obtain approval of plan when calling district office prior to setting surface pipe.
6. Submit plugging report (CP-4) to K.C.C. after plugging is completed.
7. Obtain an approved injection docket number before disposing of salt water.
8. Notify K.C.C. within 10 days when injection commences or terminates.
9. If an alternate 2 completion, cement in the production pipe from below any usable water to surface within 120 days of spud date.

**A Regular Section of Land**  
**1 Mile = 5,280 Ft.**

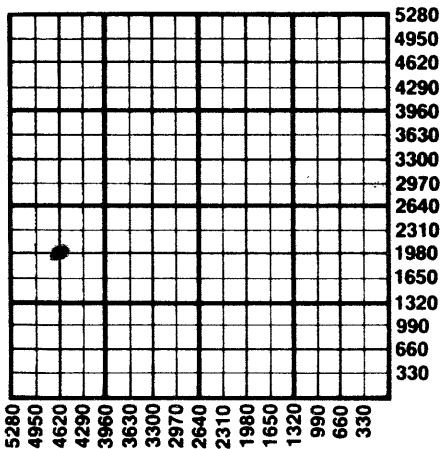

STATE CORPORATION COMMISSION

JAN 14 1967

CONSERVATION DIVISION  
Wichita, Kansas

1-14-87

State Corporation Commission of Kansas  
Conservation Division  
200 Colorado Derby Building  
Wichita, Kansas 67202  
(316) 263-3238