

CARD MUST BE TYPED

State of Kansas  
**NOTICE OF INTENTION TO DRILL**  
 (see rules on reverse side)

CARD MUST BE SIGNED

Starting Date: 8 30 84  
 month day year

API Number 15- 207-25,011-00-00

**OPERATOR:** License # 6474  
 Name Richard Oil Co.  
 Address P.O. Box 814  
 City/State/Zip Chanute, KS 66720  
 Contact Person Mark Richard  
 Phone 431-2080

SW (location) Sec. 18 Twp. 26 S, Rge 17 ☒ East  
☐ West

165 Ft North from Southeast Corner of Section  
2805 Ft West from Southeast Corner of Section  
 (Note: Locate well on Section Plat on reverse side)

**CONTRACTOR:** License # 6716  
 Name Fald Colson Drilling  
 City/State Blue Springs, MO

Nearest lease or unit boundary line 165 feet.  
 County Woodson  
 Lease Name Brinkman Trust Well # 1

Domestic well within 330 feet: ☐ yes ☒ no  
 Municipal well within one mile: ☐ yes ☒ no

**Well Drilled For:** **Well Class:** **Type Equipment:**  
☒ Oil ☐ Swd ☐ Infield ☒ Mud Rotary  
☐ Gas ☐ Inj ☒ Pool Ext. ☐ Air Rotary  
☐ OWWO ☐ Expl ☐ Wildcat ☐ Cable

Depth to Bottom of fresh water ..... feet  
 Lowest usable water formation .....  
 Depth to Bottom of usable water 200 feet  
 Surface pipe by Alternate: 1 ☐ 2 ☒  
 Surface pipe to be set 20' feet  
 Conductor pipe if any required no feet  
 Ground surface elevation ..... feet MSL  
 This Authorization Expires 2-16-85  
 Approved By 8-16-84 RC

If OWWO: old well info as follows:

Operator .....  
 Well Name .....  
 Comp Date ..... Old Total Depth .....  
 Projected Total Depth 950 feet  
 Projected Formation at TD Bart  
 Expected Producing Formations Squirrel

I certify that we will comply with K.S.A. 55-101, et seq., plus eventually plugging hole to K.C.C. specifications.

Date 7-25-84 Signature of Operator or Agent Mark Richard

Title Partner

mhc/4101E 8/16/84

Must be filed with the K.C.C. five (5) days prior to commencing well  
This card void if drilling not started within six (6) months of date received by K.C.C.


8-16-84

RECEIVED  
STATE CORPORATION COMMISSION

Important procedures to follow:

AUG 16 1984

**A Regular Section of Land**  
**1 Mile = 5,280 Ft.**

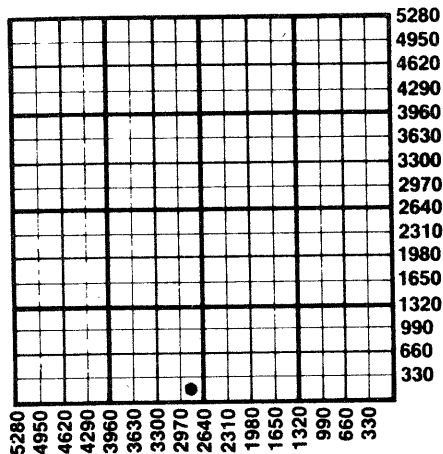

1. Notify District office before setting surface casing.
2. Set surface casing by circulating cement to the top. *Wichita, Kansas*
3. File completion forms ACO-1 with K.C.C. within 90 days of well completion, following instructions on ACO-1, side 1, and including copies of wireline logs.
4. Notify District office 48 hours prior to old well workover or re-entry.
5. Prior to plugging, prepare a plugging plan, then obtain agreement from the appropriate district office for an approved plugging plan.
6. Submit plugging report (CP-4) to K.C.C. after plugging is completed.
7. Obtain an approved injection docket number before disposing of salt water.
8. Notify K.C.C. within 10 days when injection commences or terminates.
9. If an alternate 2 completion, cement in the production pipe from below any usable water to surface within 120 days of spud date.

State Corporation Commission of Kansas  
Conservation Division  
200 Colorado Derby Building  
Wichita, Kansas 67202  
(316) 263-3238