

CARD MUST BE TYPED

State of Kansas

CARD MUST BE SIGNED

NOTICE OF INTENTION TO DRILL

(see rules on reverse side)

Starting Date Dec... 20... 1985.....
month day year

API Number 15— 163-22,849-00-00

OPERATOR: License # 6668.....
Name Theodore I. Leben.....
Address 1.05 S. Broadway #640.....
City/State/Zip Wichita, KS 67202.....
Contact Person Ted or David Leben.....
Phone (316) 264-2325.....

_____ East
SE. NE ...NW Sec. 28. Twp. 9... S, Rg. 18... West
..... 4290..... Ft. from South Line of Section
..... 2970..... Ft. from East Line of Section

(Note: Locate well on Section Plat on reverse side)

CONTRACTOR: License # 5302.....
Name Red Tiger Drilling Co.....
City/State Wichita, KS.....

Nearest lease or unit boundary line ... 990..... feet
County ... Rooks.....
Lease Name ... Carmen..... Well # ... 1-28...
Ground surface elevation .. EST .. 2165. ~~52.04~~ ... feet MSL

Well Drilled For:	Well Class:	Type Equipment:
<input checked="" type="checkbox"/> Oil	<input type="checkbox"/> SWD	<input checked="" type="checkbox"/> Mud Rotary
<input type="checkbox"/> Gas	<input type="checkbox"/> Inj	<input checked="" type="checkbox"/> Pool Ext.
<input type="checkbox"/> OWWO	<input type="checkbox"/> Expl	<input type="checkbox"/> Wildcat
		<input type="checkbox"/> Cable

Domestic well within 330 feet: _____ yes no
Municipal well within one mile: _____ yes no
Surface pipe by Alternate: 1 _____ 2 _____

If OWWO: old well info as follows:

Operator
Well Name
Comp Date Old Total Depth.....

Depth to bottom of fresh water ... 100.....
Depth to bottom of usable water ... 900.....
Surface pipe planned to be set ... 270.....
Projected Total Depth 3550..... feet
Formation ... Arbuckle.....

I certify that well will comply with K.S.A. 55-101, et seq., plus eventually plugging hole to KCC specifications.

_____ cementing will be done immediately upon setting production casing.

Date Signature of Operator or Agent *Theodore I. Leben* Title.....

RCW/KHE

For KCC Use:


Conductor Pipe Required feet; Minimum Surface Pipe Required feet per Alt. 1 2
This Authorization Expires 6-13-86..... Approved By 12-13-85 *K*.....

Must be filed with the K.C.C. five (5) days prior to commencing well
This card void if drilling not started within six (6) months of date received by K.C.C.

Important procedures to follow:

1. Notify District office before setting surface casing.
2. Set surface casing by circulating cement to the top.
3. File completion forms ACO-1 with K.C.C. within 90 days of well completion, following instructions on ACO-1, side 1, and including copies of wireline logs.
4. Notify District office 48 hours prior to old well workover or re-entry.
5. Prior to filing Intent, prepare a proposed plugging plan in case well is D & A, then obtain approval of plan when calling district office prior to setting surface pipe.
6. Submit plugging report (CP-4) to K.C.C. after plugging is completed.
7. Obtain an approved injection docket number before disposing of salt water.
8. Notify K.C.C. within 10 days when injection commences or terminates.
9. If an alternate 2 completion, cement in the production pipe from below any usable water to surface within 120 days of spud date.

A Regular Section of Land 1 Mile = 5,280 Ft.

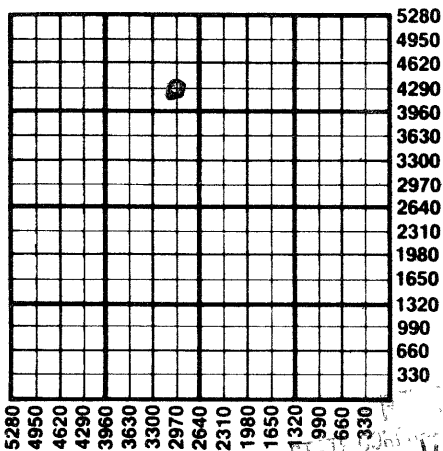

12/13/85
DEC 30 1985
CONSERVATION DIVISION
WICHITA, KANSAS

State Corporation Commission of Kansas
Conservation Division
200 Colorado Derby Building
Wichita, Kansas 67202
(316) 263-3238