

CARD MUST BE TYPED

State of Kansas  
**NOTICE OF INTENTION TO DRILL**  
 (see rules on reverse side)

CARD MUST BE SIGNED

Starting Date: April 25 1985  
 month day year 1:20

OPERATOR: License # 7981

Name Warren Meats

Address RR# 2

City/State/Zip Yates Center, Ks. 66783

Contact Person Rick Lauber

Phone 316-625-3343

CONTRACTOR: License # 6010 6010

Name Davis Drilling

City/State Yates Center, Ks

Well Drilled For: Well Class: Type Equipment:

☒ Oil ☐ Swd ☐ Infield ☒ Mud Rotary

☐ Gas ☒ Inj ☒ Pool Ext. ☐ Air Rotary

☐ OWWO ☐ Expl ☐ Wildcat ☐ Cable

If OWWO: old well info as follows:

Operator

Well Name

Comp Date Old Total Depth

Projected Total Depth 1075 feet

Projected Formation at TD Bartlesville

Expected Producing Formations

I certify that we will comply with K.S.A. 55-101, et seq., plus eventually plugging hole to K.C.C. specifications.

Date 4-25-85 Signature of Operator or Agent Rick Lauber Title

API Number 15-

W1/2 NW1/4

(location)

2880

4680

Sec 19 Twp 26 S, Rge 17

☒ East

☐ West

Ft North from Southeast Corner of Section

Ft West from Southeast Corner of Section

(Note: Locate well on Section Plat on reverse side)

Nearest lease or unit boundary line 165 feet.

County Woodson

Lease Name Jackson Well# 17

Domestic well within 330 feet: ☒ yes ☐ no

Municipal well within one mile: ☐ yes ☒ no

Depth to Bottom of fresh water 12 feet

Lowest usable water formation

Depth to Bottom of usable water 200 feet

Surface pipe by Alternate: 1 ☐ 2 ☒

Surface pipe to be set 40 feet

Conductor pipe if any required feet

Ground surface elevation feet MSL

This Authorization Expires 10-25-85

Approved By 4-25-85

MHC/WONE 4-24-85

Must be filed with the K.C.C. five (5) days prior to commencing well  
This card void if drilling not started within six (6) months of date received by K.C.C.


WICHITA, KANSAS  
CUMMINS WITH DIVISION

APR 25 1985

4-25-85

**Important procedures to follow :**

1. Notify District office before setting surface casing.
2. Set surface casing by circulating cement to the top.
3. File completion forms ACO-1 with K.C.C. within 90 days of well completion, following instructions on ACO-1, side 1, and including copies of wireline logs.
4. Notify District office 48 hours prior to old well workover or re-entry.
5. Prior to plugging, prepare a plugging plan, then obtain agreement from the appropriate district office for an approved plugging plan.
6. Submit plugging report (CP-4) to K.C.C. after plugging is completed.
7. Obtain an approved injection docket number before disposing of salt water.
8. Notify K.C.C. within 10 days when injection commences or terminates.
9. If an alternate 2 completion, cement in the production pipe from below any usable water to surface within 120 days of spud date.

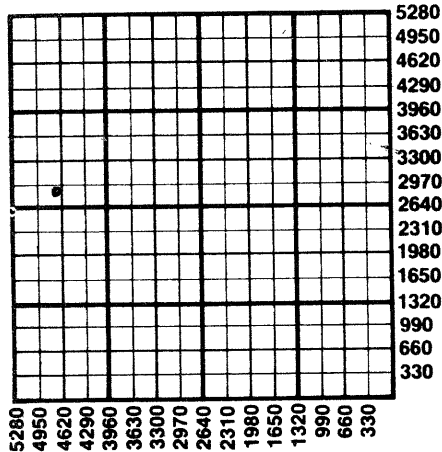

**State Corporation Commission of Kansas  
Conservation Division  
200 Colorado Derby Building  
Wichita, Kansas 67202  
(316) 263-3238**