

CARD MUST BE TYPED

State of Kansas

CARD MUST BE SIGNED

NOTICE OF INTENTION TO DRILL

(see rules on reverse side)

Starting Date 11-21-86
month day year 11/07OPERATOR: License # 4972Name Miura Petroleum, Inc.Address 430 S. EvergreenCity/State/Zip Chanute, KS 66720Contact Person Louie McAlpinePhone (316) 431-7554CONTRACTOR: License # 5378Name Fleming DrillingCity/State Chanute, KS 66720

Well Drilled For: Well Class: Type Equipment:

☒ Oil ☐ SWD ☒ Infield ☒ Mud Rotary☐ Gas ☐ Inj ☐ Pool Ext. ☐ Air Rotary☐ OWWO ☐ Expl ☐ Wildcat ☐ Cable

If OWWO: old well info as follows:

Operator

Well Name

Comp Date Old Total Depth

I certify that well will comply with K.S.A. 55-101, et seq., plus eventually plugging hole to KCC specifications.

Date 11-20-86 Signature of Operator or Agent Elaine Driskin Title As Agent

For KCC Use:

Conductor Pipe Required feet; Minimum Surface Pipe Required 20 feet per Alt. 42This Authorization Expires 5-20-87 Approved By 11-20-86API Number 15- 207-25,495-0000app. SW SE SW 22 Twp. 26 S, Rg. 17 ☒ East
165 ☐ West3465 Ft. from South Line of Section

..... Ft. from East Line of Section

(Note: Locate well on Section Plat on reverse side)

Nearest lease or unit boundary line 165 feetCounty WoodsonLease Name Ladd Well # 4Ground surface elevation n/a feet MSLDomestic well within 330 feet: ☐ yes ☒ noMunicipal well within one mile: ☐ yes ☒ noDepth to bottom of fresh water. 20Depth to bottom of usable water 150-200Surface pipe by Alternate: 1 2 ☒Surface pipe planned to be set 20Conductor pipe required n/aProjected Total Depth 900 feet

Formation


RCH/KC

Must be filed with the K.C.C. five (5) days prior to commencing well
This card void if drilling not started within six (6) months of date received by K.C.C.

Important procedures to follow:

1. Notify District office before setting surface casing.
2. Set surface casing by circulating cement to the top.
3. File completion forms ACO-1 with K.C.C. within 90 days of well completion, following instructions on ACO-1, side 1, and including copies of wireline logs.
4. Notify District office 48 hours prior to old well workover or re-entry.
5. Prior to filing Intent, prepare a proposed plugging plan in case well is D & A, then obtain approval of plan when calling district office prior to setting surface pipe.
6. Submit plugging report (CP-4) to K.C.C. after plugging is completed.
7. Obtain an approved injection docket number before disposing of salt water.
8. Notify K.C.C. within 10 days when injection commences or terminates.
9. If an alternate 2 completion, cement in the production pipe from below any usable water to surface within 120 days of spud date.

A Regular Section of Land
1 Mile = 5,280 Ft.

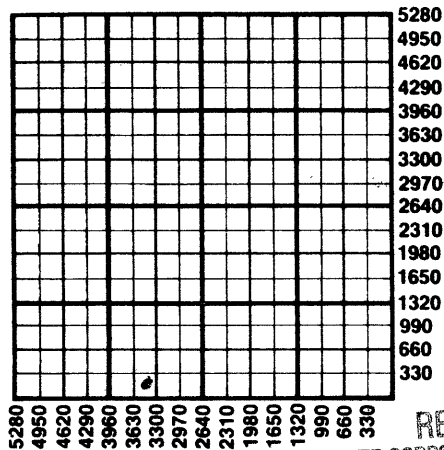

RECEIVED
STATE CORPORATION COMMISSION

NOV 20 1986
11-20-86
CONSERVATION DIVISION
Wichita, Kansas

State Corporation Commission of Kansas
Conservation Division
200 Colorado Derby Building
Wichita, Kansas 67202
(316) 263-3238