

\*\* IS 157'S & 50'W N/2 SW SW  
 \*\* IS 833' FSL  
 \*\* IS 1788'

**CORRECTED**

For KCC Use:  
 Effective Date: 4-22-07  
 District #: 4  
 SGA?  Yes  No

KANSAS CORPORATION COMMISSION  
 OIL & GAS CONSERVATION DIVISION

Form C-1

December 2002

Form must be Typed

Form must be Signed

All blanks must be Filled

**NOTICE OF INTENT TO DRILL**  
 Must be approved by KCC five (5) days prior to commencing well

Expected Spud Date 4 19 2007  
 month day year

Spot 80'S + 50'W  
 N/2 SW SW Sec. 15 Twp. 14 S. R. 13  
 East  
 West

OPERATOR: License# 33813  
 Name: Jason Oil Company, LLC  
 Address: P.O. Box 701  
 City/State/Zip: Russell, Kansas 67665  
 Contact Person: Jim Schoenberg  
 Phone: 785-483-8027

feet from  N /  S Line of Section  
 feet from  E /  W Line of Section  
 is SECTION  Regular  Irregular?

CONTRACTOR: License# 33905  
 Name: Royal Drilling, Inc.

(Note: Locate well on the Section Plat on reverse side)  
 County: Russell  
 Lease Name: Boomhower Well #: 1  
 Field Name: Halt Gurney

Well Drilled For: Well Class: Type Equipment:  
 Oil  Enh Rec  Infield  Mud Rotary  
 Gas  Storage  Pool Ext.  Air Rotary  
 OWWO  Disposal  Wildcat  Cable  
 Seismic; # of Holes  Other  
 Other

Is this a Prorated / Spaced Field?  Yes  No  
 Target Formation(s): LKC-Arbuckle

Nearest Lease or unit boundary: 610'  
 Ground Surface Elevation: 1788 feet MSL

Water well within one-quarter mile:  Yes  No  
 Public water supply well within one mile:  Yes  No

Depth to bottom of fresh water: 200'  
 Depth to bottom of usable water: 360'

Surface Pipe by Alternate:  1  2  
 Length of Surface Pipe Planned to be set: 420

Length of Conductor Pipe required: 0  
 Projected Total Depth: 3250'

Formation at Total Depth: Arbuckle  
 Water Source for Drilling Operations:  
 Well  Farm Pond  Other

DWR Permit #: \_\_\_\_\_  
 (Note: Apply for Permit with DWR )

Will Cores be taken?  Yes  No  
 If Yes, proposed zone: \_\_\_\_\_

If OWWO: old well information as follows:  
 Operator: \_\_\_\_\_  
 Well Name: \_\_\_\_\_  
 Original Completion Date: \_\_\_\_\_ Original Total Depth: \_\_\_\_\_

Directional, Deviated or Horizontal wellbore?  Yes  No

If Yes, true vertical depth: \_\_\_\_\_

Bottom Hole Location: \_\_\_\_\_

KCC DKT #: \_\_\_\_\_

# WAS: 80'S : 50'W, 910' FSL Elev. 1776  
 IS: 157'S : 50'W, 833' FSL Elev. 1788

**AFFIDAVIT**

RECEIVED  
 KANSAS CORPORATION COMMISSION

The undersigned hereby affirms that the drilling, completion and eventual plugging of this well will comply with K.S.A. 55 et. seq.

It is agreed that the following minimum requirements will be met:

1. Notify the appropriate district office **prior** to spudding of well;
2. A copy of the approved notice of intent to drill **shall be posted** on each drilling rig;
3. The minimum amount of surface pipe as specified below **shall be set** by circulating cement to the top; in all cases surface pipe shall be set through all unconsolidated materials plus a minimum of 20 feet into the underlying formation.
4. If the well is dry hole, an agreement between the operator and the district office on plug length and placement is necessary **prior to plugging**;
5. The appropriate district office will be notified before well is either plugged or production casing is cemented in;
6. If an ALTERNATE II COMPLETION, production pipe shall be cemented from below any usable water to surface within **120 days** of spud date. Or pursuant to Appendix "B" - Eastern Kansas surface casing order #133,691-C, which applies to the KCC District 3 area, alternate II cementing must be completed within 30 days of the spud date or the well shall be plugged. **In all cases, NOTIFY district office** prior to any cementing.

I hereby certify that the statements made herein are true and to the best of my knowledge and belief.

Date: 4/12/2007 Signature of Operator or Agent: Sherry Payne Title: Agent

**For KCC Use ONLY**  
 API # 15 - 167-23426-0000  
 Conductor pipe required None feet  
 Minimum surface pipe required 380 feet per Alt 1  
 Approved by: Paul 4-17-07 / Paul 4-26-07  
 This authorization expires: 10-17-07  
 (This authorization void if drilling not started within 6 months of approval date.)  
 Spud date: \_\_\_\_\_ Agent: \_\_\_\_\_

**Remember to:**

- File Drill Pit Application (form CDP-1) with Intent to Drill;
- File Completion Form ACO-1 within 120 days of spud date;
- File acreage attribution plat according to field proration orders;
- Notify appropriate district office 48 hours prior to workover or re-entry;
- Submit plugging report (CP-4) after plugging is completed;
- Obtain written approval before disposing or injecting salt water.

Well Not Drilled - Permit Expired  
 Signature of Operator or Agent: \_\_\_\_\_  
 Date: \_\_\_\_\_

Mail to: KCC - Conservation Division, 130 S. Market - Room 2078, Wichita, Kansas 67202

RECEIVED  
 APR 26 2007

CONSERVATION DIVISION  
 WICHITA, KS

IS  
 14  
 13W

**IN ALL CASES PLOT THE INTENDED WELL ON THE PLAT BELOW**

*Plat of acreage attributable to a well in a prorated or spaced field*

If the intended well is in a prorated or spaced field, please fully complete this side of the form. If the intended well is in a prorated or spaced field complete the plat below showing that the well will be properly located in relationship to other wells producing from the common source of supply. Please show all the wells and within 1 mile of the boundaries of the proposed acreage attribution unit for gas-wells and within 1/2 mile of the boundaries of the proposed acreage attribution unit for oil wells.

API No. 15 - 16 7-23426-0000  
 Operator: Jason Oil Company, LLC  
 Lease: Boomhower  
 Well Number: 1  
 Field: Hall-Gurney  
 Number of Acres attributable to well: \_\_\_\_\_  
 QTR / QTR / QTR of acreage: N/2 - SW - SW



Location of Well: County: Russell  
910 feet from  N /  S Line of Section  
4670 feet from  E /  W Line of Section  
 Sec. 15 Twp. 14 S. R. 13  East  West

Is Section:  Regular or  Irregular

If Section is Irregular, locate well from nearest corner boundary.  
 Section corner used:  NE  NW  SE  SW

**PLAT**

(Show location of the well and shade attributable acreage for prorated or spaced wells.)  
 (Show footage to the nearest lease or unit boundary line.)

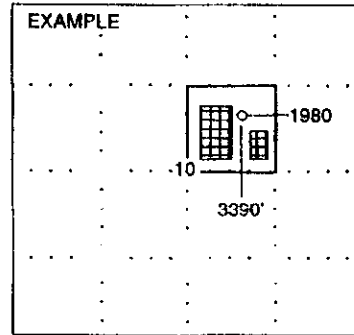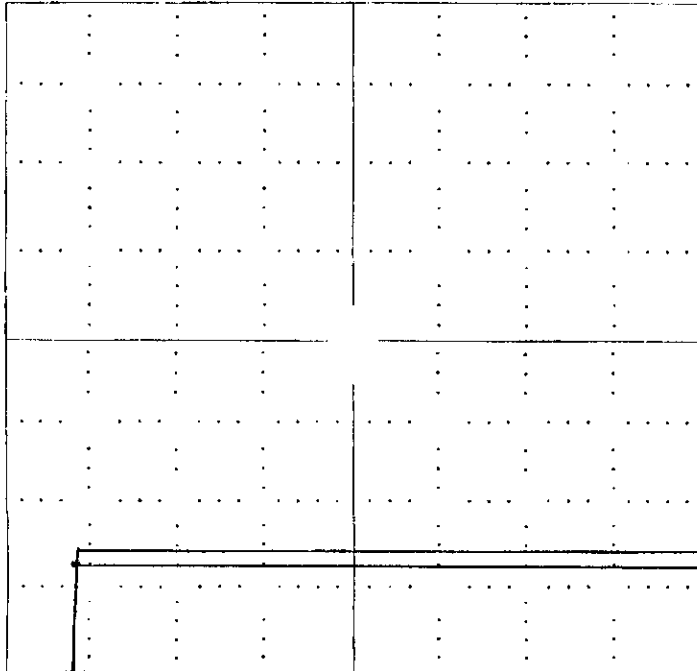

NOTE: In all cases locate the spot of the proposed drilling location.

4670' FEL

15 : 853' FEL 910' FSL WAS

**In plotting the proposed location of the well, you must show:**

1. The manner in which you are using the depicted plat by identifying section lines, i.e. 1 section, 1 section with 8 surrounding sections, 4 sections, etc.
2. The distance of the proposed drilling location from the section's south / north and east / west.
3. The distance to the nearest lease or unit boundary line.
4. If proposed location is located within a prorated or spaced field a certificate of acreage attribution plat must be attached: (CO-7 for oil wells; CG-8 for gas wells).

\*\* IS 157'S & 50'W N/2 SW SW  
 \*\* IS 833' FSL

KANSAS CORPORATION COMMISSION  
 OIL & GAS CONSERVATION DIVISION  
**APPLICATION FOR SURFACE PIT**

**CORRECTED**

Form CDP-1  
 April 2004  
 must be Typed

Submit in Duplicate

Operator Name: <b>Jason Oil Company, LLC</b>		License Number: <b>33813</b>
Operator Address: <b>P.O. Box 701, Russell, Kansas 67665</b>		
Contact Person: <b>Jim Schoenberger</b>		Phone Number: <b>( 785 ) 483 - 8027</b>
Lease Name & Well No.: <b>Boomhower #1</b>		Pit Location (QQQQ): <b>157'S</b> <b>80'S</b> L. <b>50'W</b> N/2 SW SW Sec. <b>15</b> Twp. <b>14S</b> R. <b>13</b> <input type="checkbox"/> East <input checked="" type="checkbox"/> West If Existing, date constructed: <b>810</b> <b>833</b> Feet from <input type="checkbox"/> North / <input checked="" type="checkbox"/> South Line of Section <b>4670</b> Feet from <input checked="" type="checkbox"/> East / <input type="checkbox"/> West Line of Section <b>Russell</b> County
Type of Pit: <input type="checkbox"/> Emergency Pit <input type="checkbox"/> Burn Pit <input type="checkbox"/> Settling Pit <input checked="" type="checkbox"/> Drilling Pit <input type="checkbox"/> Workover Pit <input type="checkbox"/> Haul-Off Pit <i>(If WP Supply API No. or Year Drilled)</i>	Pit is: <input checked="" type="checkbox"/> Proposed <input type="checkbox"/> Existing If Existing, date constructed: Pit capacity: <b>400</b> (bbls)	
Is the pit located in a Sensitive Ground Water Area? <input type="checkbox"/> Yes <input checked="" type="checkbox"/> No		Chloride concentration: _____ mg/l <i>(For Emergency Pits and Settling Pits only)</i>
Is the bottom below ground level? <input checked="" type="checkbox"/> Yes <input type="checkbox"/> No	Artificial Liner? <input type="checkbox"/> Yes <input checked="" type="checkbox"/> No	How is the pit lined if a plastic liner is not used? <b>Native Mud</b>
Pit dimensions (all but working pits): <b>80</b> Length (feet) <b>80</b> Width (feet) <b>N/A: Steel Pits</b> Depth from ground level to deepest point: <b>6</b> (feet)		
If the pit is lined give a brief description of the liner material, thickness and installation procedure.		Describe procedures for periodic maintenance and determining liner integrity, including any special monitoring.
Distance to nearest water well within one-mile of pit <b>N/A</b> feet Depth of water well _____ feet		Depth to shallowest fresh water <b>200</b> feet. Source of information: _____ measured <input checked="" type="checkbox"/> well owner _____ electric log _____ KDWR
<b>Emergency, Settling and Burn Pits ONLY:</b> Producing Formation: _____ Number of producing wells on lease: _____ Barrels of fluid produced daily: _____ Does the slope from the tank battery allow all spilled fluids to flow into the pit? <input type="checkbox"/> Yes <input type="checkbox"/> No		<b>Drilling, Workover and Haul-Off Pits ONLY:</b> Type of material utilized in drilling/workover: <b>Fresh Mud</b> Number of working pits to be utilized: <b>3</b> Abandonment procedure: <b>Allow to dry and backfill</b> Drill pits must be closed within 365 days of spud date.
I hereby certify that the above statements are true and correct to the best of my knowledge and belief.		
Date: <b>4-12-07</b>		Signature of Applicant or Agent: <b>Sherry Payne</b> <b>APR 16 2007</b>

15767-23426-0000

<b>KCC OFFICE USE ONLY</b>		
Date Received: <b>4/16/07</b>	Permit Number: _____	Permit Date: <b>4/16/07</b> Lease Inspection Date: _____

Mail to: KCC - Conservation Division, 130 S. Market - Room 2078, Wichita, Kansas 67202

RECEIVED  
 KANSAS CORPORATION COMMISSION

RECEIVED  
 KANSAS CORPORATION COMMISSION

APR 26 2007

CONSERVATION DIVISION  
 WICHITA, KS