

STATE OF KANSAS
STATE CORPORATION COMMISSION

WELL PLUGGING RECORD

Give All Information Completely
Make Required Affidavit
Mail or Deliver Report to:
Conservation Division
State Corporation Commission
800 Bittling Building
Wichita, Kansas

Rooks County. Sec. 29 Twp. 9S Rge. 18 (X) (W)

Location as "NE/CNW $\frac{1}{4}$ /SW $\frac{1}{4}$ " or footage from lines NE SW NW

Lease Owner Heathman & Company

Lease Name Baumgartner Well No. 5

Office Address 254 N. Washington Wichita, Kansas.

Character of Well (completed as Oil, Gas or Dry Hole) Dry Hole

Date well completed 8-10 19 53

Application for plugging filed 8-9 19 53

Application for plugging approved 8-9 19 53


Plugging commenced 8-10 1:00 A. M. 19 53

Plugging completed 8-10 4:00 A. M. 19 53

Reason for abandonment of well or producing formation Dry Hole

If a producing well is abandoned, date of last production _____ 19 _____

Was permission obtained from the Conservation Division or its agents before plugging was commenced? Yea Verbal

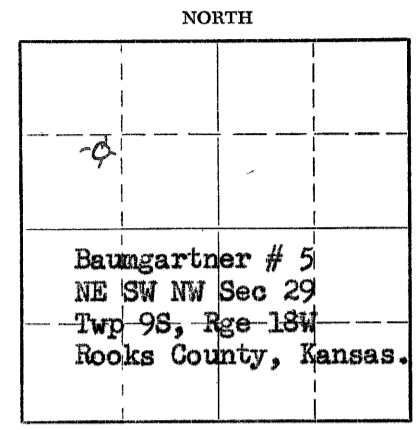

Locate well correctly on above Section Plat

Name of Conservation Agent who supervised plugging of this well Eldon Petty

Producing formation _____ Depth to top _____ Bottom _____ Total Depth of Well 3380 Feet

Show depth and thickness of all water, oil and gas formations.

OIL, GAS OR WATER RECORDS

CASING RECORD

| FORMATION | CONTENT | FROM | TO | SIZE | PUT IN | PULLED OUT |
|---------------------|---------|------|------|-------|--------|------------|
| Postrock, Sand | | | | | | |
| Blue Shale & Shells | | 0 | 159' | 8 5/8 | 159' | None |
| Shale & Shells | | 465 | 1534 | | | |
| Anhydrite | | 1534 | 1575 | | | |
| Lime & Shale | | 2080 | 3275 | | | |
| Lime | | 3275 | 3380 | | | |
| Total Depth | | 3380 | | | | |

Describe in detail the manner in which the well was plugged, indicating where the mud fluid was placed and the method or methods used in introducing it into the hole. If cement or other plugs were used, state the character of same and depth placed, from _____ feet to _____ feet for each plug set.

Stirred pits well filled hole with heavy mud. Set bottom wood plug @ 150'.
Ran 1/2 sack hulls and 15 sacks of cement. Filled hole with heavy mud to 40'.
Ran 1/2 sack hulls and 10 sacks of cement filling to the bottom of the cellar.

(If additional description is necessary, use BACK of this sheet)

Name of Plugging Contractor Strain Drilling Company

Address Box 188 Hays, Kansas.

STATE OF KANSAS COUNTY OF ELLIS, ss.

T. G. Strain (employee of owner) or (owner or operator) of the above-described well, being first duly sworn on oath, says: That I have knowledge of the facts, statements, and matters herein contained and the log of the above-described well as filed and that the same are true and correct. So help me God.

(Signature) T. G. Strain
Box 188 Hays, Kansas.
(Address)

SUBSCRIBED AND SWORN TO before me this 11th day of August, 19 53

My commission expires March 26, 1956

Mildred Schneider
Notary Public.

Received
8/19/53

PLUGGING
FILE SEC 29 T 8 R 18W
BOOK 21 17

WELL LOG

COMPANY: Heathman & Company

NE SW NW Sec. 29
Twp 9S, Rge 18W
Rocks County, Kansas.

LEASE: Baumgartner # 5

ELEVATION: 2188 R. B.

NOTE: All meas rotary bushing

| | | |
|------|-----------------|---------------------|
| 0 | 70 | Post rock & Sand |
| 70 | 159 | Blue Shale & Shells |
| 159 | 465 | Shale |
| 465 | 625 | Shale & Shells |
| 625 | 800 | Sand & Shale |
| 800 | 1025 | Shale & Shells |
| 1025 | 1255 | Sand & Shale |
| 1255 | 1275 | Shale & Shells |
| 1275 | 1534 | Redbed & Shells |
| 1534 | 1575 | Anhydrite |
| 1575 | 1610 | Shale & Shells |
| 1610 | 2080 | Shale & Shells |
| 2080 | 2240 | Lime & Shale |
| 2240 | 2365 | Lime & Shale |
| 2365 | 2400 | Lime & Shale |
| 2400 | 2460 | Lime |
| 2460 | 2475 | Lime & Shale |
| 2475 | 2630 | Lime & Shale |
| 2630 | 2730 | Lime & Shale |
| 2730 | 2820 | Lime & Shale |
| 2820 | 3000 | Lime & Shale |
| 3000 | 3155 | Lime & Shale |
| 3155 | 3245 | Lime & Shale |
| 3245 | 3275 | Lime |
| 3275 | 3340 | Lime |
| 3340 | 3380 | Lime |
| 3380 | (Total Depth) | |

COMMENCED: 8-3-53
COMPLETED: 8-10-53

CASING RECORD:

8 5/8 Surface Casing set at 159' W/115
Sacks of cement by Sun Cementing Co.

No Electric Logs Run

Geologist; Bob Armstrong.

TOPS:

Geological

| | |
|-----------|--------------|
| Anhydrite | 1534 (+654) |
| Topoka | 3120 (-932) |
| Heebner | 3332 (-1144) |

| | |
|-------------|--------------|
| Tronto | 3352 (-1164) |
| Kansas City | 3372 (-1184) |
| T. Depth | 3380 (-1192) |

STATE OF KANSAS) SS
COUNTY OF ELLIS)

I hereby affirm that the above and foregoing is a true and correct copy of the log of the Baumgartner # 5, located NE SW NW, Sec 29, Twp 9S, Rge 18W, Rocks County, Kansas.

CONTRACTOR: Strain Drilling Company

BY: T. C. Strain
T. C. Strain

Subscribed and sworn to before me this 11th day of August 1953.
My commission expires March 26, 1956

Michael Schneider
Notary Public.

PLUGGING
WELL SEC 29 T 9 S R 18 W
BLOCK 21 COR 17

Received
8/19/53