


Give All Information Completely
Make Required Affidavit
Mail or Deliver Report to:
Conservation Division
State Corporation Commission
800 Biffing Building
Wichita, Kansas

WELL PLUGGING RECORD

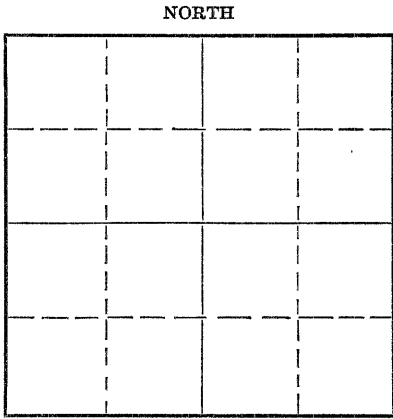

Locate well correctly on above
Section Plat

Rooks County. Sec. 3 Twp. 9S Rge. (E) 19 (W)
Location as "NE/CNW $\frac{1}{4}$ SW $\frac{1}{4}$ " or footage from lines 2310' from North & 1650'
Lease Owner Continental Oil Co. from West lines
Lease Name C. Novotny Well No. 1
Office Address Drawer 1267, Ponca City, Oklahoma
Character of Well (completed as Oil, Gas or Dry Hole) Oil
Date well completed 7-21-45 19
Application for plugging filed 12-16-52 19
Application for plugging approved 12-22-52 19
Plugging commenced 1-9-53 19
Plugging completed 1-14-53 19
Reason for abandonment of well or producing formation Depleted

If a producing well is abandoned, date of last production 12-31-52 19
Was permission obtained from the Conservation Division or its agents before plugging was commenced? Yes

Name of Conservation Agent who supervised plugging of this well Eldon Petty - Hays, Kansas
Producing formation Lansing Depth to top 3218 Bottom 3461 Total Depth of Well 3503 Feet
Show depth and thickness of all water, oil and gas formations.

OIL, GAS OR WATER RECORDS

CASING RECORD

Formation	Content	From	To	Size	Put In	Pulled Out
<u>Lansing</u>	<u>Depleted</u>	<u>3218</u>	<u>3461</u>	<u>10 3/4</u>	<u>240'</u>	<u>None</u>
				<u>6</u>	<u>3487'6"</u>	<u>2088'1"</u>

Describe in detail the manner in which the well was plugged, indicating where the mud fluid was placed and the method or methods used in introducing it into the hole. If cement or other plugs were used, state the character of same and depth placed, from _____ feet to _____ feet for each plug set.

Filled hole with rock to 3390' and dumped 5 sacks cement. Pulled pipe.
Filled hole with heavy mud to 250'; set 10' rock bridge and dumped 20 sacks
cement. Filled hole with heavy mud to 30' and capped with 10 sacks.
P&A 1-14-53.

RECEIVED
STATE CORPORATION COMMISSION
2/17/53
FEB 17 1953
CONSERVATION DIVISION
Wichita, Kansas

(If additional description is necessary, use BACK of this sheet)
Name of Plugging Contractor West Supply Company
Address Chase, Kansas

STATE OF Kansas, COUNTY OF Barton, ss.
F. L. Dunn (employee of owner) or (owner or operator) of the above-described well,

being first duly sworn on oath, says: That I have knowledge of the facts, statements, and matters herein contained and the log of the above-described well as filed and that the same are true and correct. So help me God.

JMW-JMW
State Corp. Comm.
TCD
File
(Signature) F. L. Dunn
Box 161, Great Bend, Kansas
(Address)

SUBSCRIBED AND SWORN to before me this 5th day of February, 1953.

My commission expires August 25, 1956 Notary Public.

PLUGGING
FILE SEC 3-7-9-R-1953
BOOK PAGE 67 LINE 10

CONTINENTAL OIL CO.

PRODUCTION & DRILLING DEPT.

NEW WELL COMPLETION AND/OR ABANDONMENT RECORD

A. F. E. NO.

1 Dist. West Kansas Field Berry Lease C. Novotny Well No. 1
 2 Co. Hooks State Kansas Contractor West Supply Co. T.D. 3503 P.D. 3461 ft.
 3 Landing Flange Elev. + _____ ft. Depth Measured From DT 2023; Height of Measuring Point from Landing Flange _____ ft.
 4 Date: Spudded 1-9-53 Drilling Completed 1-14-53 Tested PA 1-14-53 Rig Released _____

CASING, LINER AND TUBING RECORD

5	SIZE O. D. IN.	WT. LB./FT.	THREADS NO. & TYPE	GRADE AND MAKE	NEW OR S. H.	E. L. L. W. SMLS.	DEPTH SET FT.	MEASUREMENTS INC. THREADS			TOP OF LINER	NO. OF JOINTS	HOLE SIZE
								QUANTITY SET	QUANTITY PULLED	QUANTITY LEFT IN HOLE			
6	10 3/4	28		ARMOO	N	37	238	240	None	240		6	
7	6	15	3RT	H-40	N	mls	3463	3487'6"	2088'1"	1399'5"		66	pulled

CEMENTING RECORD

14	METHOD	MAKE AND TYPE CEMENT	SACKS USED	SQUEEZED AWAY	NO. OF BATCHES	FINAL PRESSURE	SLURRY WT. LB./GAL.	HOURS SET	DEPTH		REMARKS: TEMP. CALIPER. OTHER LOGS
									FROM	TO	
15											
16											
17											
18											

ACIDIZATION AND SHOT RECORD

19	DATE	PRODUCTION OR P. I.		HOW TEST MADE	GAL. ACID	SHOT QTS.	DEPTH		NAME OF ZONE	TYPE FORMATION	REMARKS
		BEFORE	AFTER				FROM	TO			
20											
21											
22											

SECTION PERFORATED

23	NAME OF PAY	DEPTH		SIZE OF HOLE	HOLES PER FOOT	DATE	SERVICE CO. OR TYPE SLOTS	REMARKS
		FROM	TO					
24								
25								
26								
27								
28								

PRODUCING EQUIPMENT

29 RODS: Number _____ Size _____ in., Number _____ Size _____ in., Total Singles _____ Length _____ ft.
 30 PUMP: Size _____ Plunger Diam. _____ Make _____ Type _____
 31 PUMPING UNIT: Make _____ Type _____ Stroke _____ in. @ _____ SPM; Beam Capacity _____ lb.
 Torque @ 20 SPM _____ in. lbs.; Gear Box _____ H.P., Prime Mover Make _____
 33 H.P. @ _____ RPM. Other Remarks _____
 34 GAS ANCHOR _____
 35 OTHER LIFT EQUIPMENT _____
 36 _____
 37 PACKER: Set at _____ ft. Make _____ (ALSO SEE SKETCH) (ON REVERSE SIDE)

PRODUCING STRATA

38	NAME	TOP	BASE	POROSITY %	PERM. MD.	NET THICKNESS FT.	REMARKS: STATE CONTENTS OF ALL PRODUCING STRATA, O. G. & W. GIVING FLUID CONTACTS, D. S. T., ETC.
39	Arbuckle	3462	3503				Small show of oil. Plugged off.
40							
41	Laning	3218	3461				Depleted
42							

REMARKS: Moved in casing pulling tools. Filled hole with rock to 3390' and dumped 3 sacks cement. Worked casing under 6" tension. Loaded casing with water and shot at 2800', 2700', 2580' and 2490'. Increased tension. Could not work loose. Shot at 2385', 2300', 2210' and 2080'. Worked pipe up 4" but would not come loose. Pumped 60 bbls. oil behind pipe. Found bridge at 1630'. Knocked it out. Shot pipe at 2050'. Worked loose and pulled 66 joints. Filled hole with heavy mud to 250' and set 10' rock bridge. Dumped 20 sacks. Filled hole with heavy mud to 30' and capped with 10 sacks cement. PA 1-14-53.

Material left in hole cleaned on WT 53394A.

Location: 2310' from North and 1650' from West line of Sec. 3, T9S, R19W, Hooks County, Kansas.

Estimate Total Cost \$ 829.35 Conoco Interest 100 % Operated by Continental Oil Company

Potential _____ b/d-Mcf/d @ _____ #TP and #CP on _____ Hr. Test Meas. Est. Allowable _____ b/d

Other Production or Well Test Results _____

59 Signed [Signature] District Superintendent
 60 Signed [Signature] Division Superintendent
 61 Signed [Signature] Region Manager
 62 Signed [Signature] District Engineer
 63 Prepared by T. D. White Date February 11, 1953
 64 _____

DISTRIBUTED TO
 Mgr. P. & D. [Signature] Acct'g [Signature]
 Region [Signature] District [Signature]
 Others [Signature]