


STATE OF KANSAS
STATE CORPORATION COMMISSION

WELL PLUGGING RECORD

Give All Information Completely
Make Required Affidavit
Mail or Deliver Report to
Conservation Division
State Corporation Comm.
245 North Water
Wichita, KS 67202

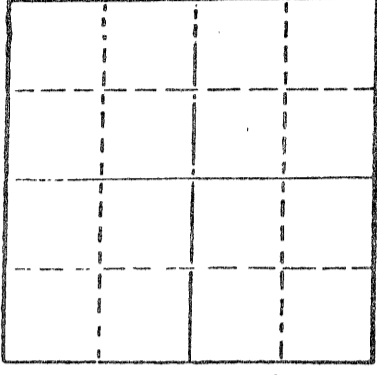

Locate well correctly on above
Section Plat

Rooks County. Sec. 29 Twp. 9s Rge. 18 E/W
Location as "NE/CNW 1/4 SW 1/4" or footage from lines
C E/2 SE NW
Lease Owner Oil Property Management, Inc.
Lease Name Baumgartner Well No. A7
Office Address 221 N. Main Suite 200 Wichita, Kans.
Character of Well (Completed as Oil, Gas or Dry Hole) dry hole
Date Well completed 8/17/80 19
Application for plugging filed 8/17/80 19
Application for plugging approved 8/17/80 19
Plugging commenced 8/17/80 5:00 A. M. 19
Plugging completed 8/17/80 6:00 A. M. 19
Reason for abandonment of well or producing formation _____

If a producing well is abandoned, date of last production _____ 19

Was permission obtained from the Conservation Division or its agents before plugging was commenced? yes

Name of Conservation Agent who supervised plugging of this well Marion Schmidt
Producing formation _____ Depth to top _____ Bottom _____ Total Depth of Well _____
Show depth and thickness of all water, oil and gas formations.

OIL, GAS OR WATER RECORDS

CASING RECORD

FORMATION	CONTENT	FROM	TO	SIZE	PUT IN	PULLED OUT

Describe in detail the manner in which the well was plugged, indicating where the mud fluid was placed and the method or methods used in introducing it into the hold. If cement or other plugs were used, state the character of same and depth placed, from _____ feet to _____ feet for each plug set.

- 1st plug at 800' with 70 sacks
- 2nd 180' with 25 sacks
- 3rd 40' with 10 sacks
- Rat Hole 5 sacks
- Total 110 sacks 50/50 poz 6% gel

RECEIVED
STATE CORPORATION COMMISSION
8/20/80
AUG 20 1980
CONSERVATION DIVISION
Wichita, Kansas

(If additional description is necessary, use BACK of this sheet)

Name of Plugging Contractor Lawbanco Drilling, Inc.
Box 289 Natoma, Kansas 67651


STATE OF Kansas COUNTY OF Osborne, ss.
R. L. Finney (employee of owner) or (owner or operator)

of the above-described well, being first duly sworn on oath, says: That I have knowledge of the facts, statements, and matters herein contained and the log of the above-described well as filed and that the same are true and correct. So help me God.

(Signature) R. L. Finney
Box 289 Natoma, Kansas 67651
(Address)

SUBSCRIBED AND SWORN TO before me this 19th day of August, 19 80

My commission expires

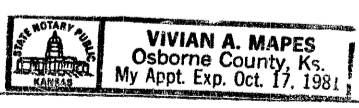
VIVIAN A. MAPES
Osborne County, Ks.
My Appt. Exp. Oct. 17, 1981

Vivian A. Mapes
Vivian A. Mapes Notary Public.

KANSAS

WELL COMPLETION REPORT AND DRILLER'S LOG

API No. 15 — Rooks County — 163-21,115-00-00 Number

S. 29 T. 9 S. R. 18 E. W
 Loc. C E/2 SE NW
 County Rooks

Operator Oil Property Management, Inc.

Address 221 N. Main Suite 200 Wichita, Kansas 67202


Well No. A-7 Lease Name Baumgartner

Footage Location
 feet from (N) (S) line _____ feet from (E) (W) line _____

Principal Contractor Lawhance Drilling, Inc. Geologist Dick Green

Spud Date 8/12/80 Date Completed 8/17/80 Total Depth 3400 P.B.T.D. _____

Directional Deviation _____ Oil and/or Gas Purchaser _____

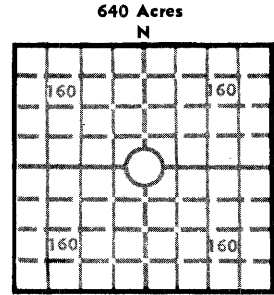

Locate well correctly
 Elev.: Gr. 2176
 DF 2178 KB 2181

CASING RECORD

Report of all strings set — surface, intermediate, production, etc.

Purpose of string	Size hole drilled	Size casing set (in O.D.)	Weight lbs/ft.	Setting depth	Type cement	Sacks	Type and percent additives
Surface	12 1/4	8 5/8	24	195'	CL A	100	2% gel 3% cc

LINER RECORD

PERFORATION RECORD

Top, ft.	Bottom, ft.	Sacks cement	Shots per ft.	Size & type	Depth interval

TUBING RECORD

Size	Setting depth	Packer set at

ACID, FRACTURE, SHOT, CEMENT SQUEEZE RECORD

Amount and kind of material used	Depth interval treated

INITIAL PRODUCTION

Date of first production _____		Producing method (flowing, pumping, gas lift, etc.) _____			
RATE OF PRODUCTION PER 24 HOURS	Oil _____ bbls.	Gas _____ MCF	Water _____ bbls.	Gas-oil ratio _____ CFPB	
Disposition of gas (vented, used on lease or sold) _____			Producing interval(s) _____		

INSTRUCTIONS: As provided in KCC Rule 82-2-125, within 90 days after completion of a well, one completed copy of this Drillers Log shall be transmitted to the State Geological Survey of Kansas, 4150 Monroe Street, Wichita, Kansas 67209. Copies of this form are available from the Conservation Division, State Corporation Commission, 245 No. Water, Wichita, Kansas 67202. Phone AC 316-522-2206. If confidential custody is desired, please note Rule 82-2-125. Drillers Logs will be on open file in the Oil and Gas Division, State Geological Survey of Kansas, Lawrence, Kansas 66044.

Operator Oil Property Management, Inc. DESIGNATE TYPE OF COMP.: OIL, GAS, DRY HOLE, SWDW, ETC.: dry hole

Well No. A 7 Lease Name Baumgartner

S 29 T9S R18W E C E/2 SE NW

WELL LOG
 Show all important zones of porosity and contents thereof; cored intervals, and all drill-stem tests, including depth interval tested, cushion used, time tool open, flowing and shut-in pressures, and recoveries. SHOW GEOLOGICAL MARKERS, LOGS RUN, OR OTHER DESCRIPTIVE INFORMATION.

FORMATION DESCRIPTION, CONTENTS, ETC.	TOP	BOTTOM	NAME	DEPTH
0 to 195 Surface dirt, Clay and Shale				
195 to 400 Sand and Shale				
400 to 1551 Shale and Sand				
1551 to 1586 Anhydrite				
1586 to 2030 Sand and Shale				
2030 to 2325 Shale and Shells				
2325 to 2590 Shale				
2590 to 2775 Shale				
2775 to 2972 Shale and Lime				
2972 to 3400 Lime RTD				

RECEIVED
 STATE CORPORATION COMMISSION
 8/20/80
 AUG 20 1980
 CONSERVATION DIVISION
 Wichita, Kansas

USE ADDITIONAL SHEETS, IF NECESSARY, TO COMPLETE WELL RECORD.

Date Received _____
 Signature R. J. Finney
 Title Drilling Superintendent
 Date August 19, 1980