


STATE OF KANSAS  
STATE CORPORATION COMMISSION

Give All Information Completely  
Make Required Affidavit  
Mail or Deliver Report to:  
Conservation Division  
State Corporation Commission  
800 Bitting Building  
Wichita, Kansas

WELL PLUGGING RECORD

NORTH

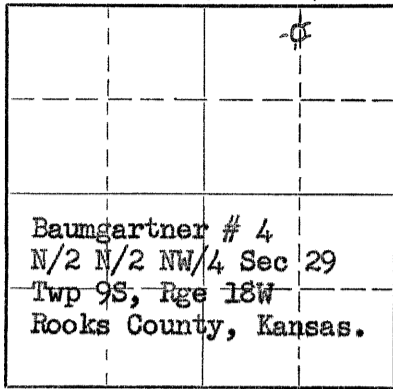

Locate well correctly on above Section Plat

Rooks County. Sec. 29 Twp. 9S Rge. 18 (E) W (W)  
Location as "NE/CNW/SW" or footage from lines N/2 N/2 NW/4  
Lease Owner Heathman & Company  
Lease Name Baumgartner Well No. 4  
Office Address 254 N. Washington Wichita, Kansas.  
Character of Well (completed as Oil, Gas or Dry Hole) Dry Hole  
Date well completed 7-17 19 53  
Application for plugging filed 7-17 19 53  
Application for plugging approved 7-17 19 53  
Plugging commenced 7-17 5:00 P. M. 19 53  
Plugging completed 7-17 9:00 P. M. 19 53  
Reason for abandonment of well or producing formation Dry Hole

If a producing well is abandoned, date of last production \_\_\_\_\_ 19 \_\_\_\_\_  
Was permission obtained from the Conservation Division or its agents before plugging was commenced? Yea Verbal

Name of Conservation Agent who supervised plugging of this well Eldon Petty  
Producing formation \_\_\_\_\_ Depth to top \_\_\_\_\_ Bottom \_\_\_\_\_ Total Depth of Well 3630 Feet  
Show depth and thickness of all water, oil and gas formations.

OIL, GAS OR WATER RECORDS

CASING RECORD

FORMATION	CONTENT	FROM	TO	SIZE	PUT IN	PULLED OUT
Soil, Clay & Shale		0	157'	8 5/8	157'	None
Anhydrite		1522	1560			
Shale & Shells		1560	1940			
Lime & Shale		1940	3605			
Conglomerate		3605	3630			
Total Depth						

Describe in detail the manner in which the well was plugged, indicating where the mud fluid was placed and the method or methods used in introducing it into the hole. If cement or other plugs were used, state the character of same and depth placed, from \_\_\_\_\_ feet to \_\_\_\_\_ feet for each plug set.

Stirred pits well filled hole with heavy mud to 155' set bottom wood plug. Ran 1/2 sack hulls and 15 sacks of cement on same. Filled hole with heavy mud to 40' set plug. Ran 1/2 sack hulls and 10 sacs of cement filling to the bottom of the cellar.

(If additional description is necessary, use BACK of this sheet)

Name of Plugging Contractor Strain Drilling Company  
Address Box 188 Hays, Kansas.


STATE OF Kansas, COUNTY OF Ellis, ss.  
T. C. Strain (employee of owner) or (owner or operator) of the above-described well, being first duly sworn on oath, says: That I have knowledge of the facts, statements, and matters herein contained and the log of the above-described well as filed and that the same are true and correct. So help me God.

(Signature) T. C. Strain  
Box 188 Hays, Kansas. (Address)

SUBSCRIBED AND SWORN TO before me this 20th day of July, 19 53

Mildred Schneider  
Notary Public.

My Commission expires March 26, 1956

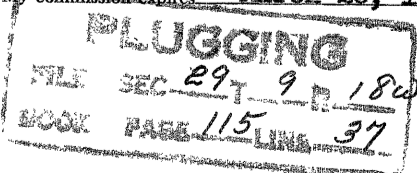

7/29/53  
STATE OIL  
COMM.

WELL LOG

COMPANY: Heathman & Company

N/2-N/2-NW/4 Sec 29  
Twp 9S, Rge 18W  
Rooks County, Kansas.

LEASE: Baumgartner # 4

ELEVATION: 2184 R. B.

NOTE: All meas Rotary Bushing

0	40 Soil & Clay
40	157 Shale
157	260 Shale Blue
260	500 Blue Shale & Shells
500	825 Shale & Shells
825	1030 Sandy Shale
1030	1270 Sand
1270	1415 Shale, Shells & Redbed
1415	1522 Redbed
1522	1545 Anhydrite
1545	1560 Anhydrite
1560	1940 Shale & Shells
1940	2200 Shale & Shells
2200	2240 Lime & Shale
2240	2300 Lime & Shale
2300	2335 Lime
2335	2345 Lime & Shale
2345	2445 Lime & Shale
2445	2610 Lime & Shale
2610	2710 Lime & Shale
2710	2805 Lime
2805	2920 Lime & Shale
2920	2950 Lime & Shale
2950	3085 Shale & Lime
3085	3210 Lime & Shale
3210	3275 Lime
3275	3315 Lime
3315	3380 Lime & Shale
3380	3425 Lime
3425	3470 Lime

3470	3515 Lime
3515	3575 Lime
3575	3605 Lime & Shale
3605	3622 Conglomerate
3622	3630 Conglomerate
3630	( Total Depth )

COMMENCED: 7-9-53  
COMPLETED: 7-17-53

CASING RECORD:

8 5/8 Surface Casing set at 157' W/100  
sacks of cement by Sun Cementing Co.

No Electric Logs Run

Geologist: Bob Armstrong.

TOPS: Geological

Anhydrite	1522 (+662)	Lansing K. C.	3363 (-1179)
Topeka	3114 (-930)	Base K. C.	3568 (-1384)
Heebner	3322 (-1138)	Conglomerate	3605 (-1421)
Tronto	3342 (-1158)	T. D.	3630 (-1446)

STATE OF KANSAS) SS  
COUNTY OF ELLIS)

I hereby affirm that the above and foregoing is a true and correct copy of the log  
of the Baumgartner # 4, located N/2 N/2 NW/4, Sec 29, Twp 9S, Rge 18W, Rooks County, Kansas

CONTRACTOR: Strain Drilling Company

BY: T. C. Strain  
T. C. Strain

Subscribed and sworn to before me this 20th day of July 1953.  
My commission expires March 26, 1956

Mildred Schneider  
Notary Public

**PLUGGING**  
FILE SEC 29 T 9 R 18 W  

RECEIVED  
STATE CORPORATION COMMISSION  
7/29/53  
JUL 29 1953  
CORPORATION DIVISION  
WASHTON, KANSAS