

CARD MUST BE TYPED

State of Kansas

CARD MUST BE SIGNED

# NOTICE OF INTENTION TO DRILL

\*CORRECTION\*

(see rules on reverse side)

Expected Spud Date... AUGUST 14, 1987  
month day year

API Number 15-207-25,532-00-00

OPERATOR: License # 5401

NW SW SW Sec. 29 Twp. 26 S, Rg. 17  East  West

Name ARKANDAS, INC.

1275 Ft. from South Line of Section

Address 1102 W. 1st

5115 Ft. from East Line of Section

City/State/Zip CHANUTE, KS 66720

Contact Person JOHN MEARS

Phone (316) 431-2129

(Note: Locate well on Section Plat on reverse side)

Nearest lease or unit boundary line 1275 feet

County WOODSON

CONTRACTOR: License # 5378

Lease Name DALE G. NELSON Well # 1

Name FLEMING DRILLING, INC.

Ground surface elevation feet MSL

City/State 1209 PLUMMER, CHANUTE, KS 66720

Domestic well within 330 feet:  yes  no

\*Well Drilled For: Well Class: Type Equipment:

Municipal well within one mile:  yes  no

Oil  Storage  Infield  Mud Rotary

Depth to bottom of fresh water

Gas  Inj  Pool Ext.  Air Rotary

Depth to bottom of usable water 200

OWWO  Expl  Wildcat  Cable

Surface pipe by Alternate: 1  2

If OWWO: old well info as follows:

Surface pipe planned to be set 40

Operator

Conductor pipe required

Well Name

Projected Total Depth 1000 feet

Comp Date Old Total Depth

Formation BARTLESVILLE

I certify that well will comply with K.S.A. 55-101, et seq., plus eventually plugging hole to KCC specifications.

Date 8/21/87 Signature of Operator or Agent

AS. AGENT

For KCC Use:

Conductor Pipe Required feet; Minimum Surface Pipe Required 20 feet per Alt. X<sup>2</sup>

This Authorization Expires 2-13-88 Approved By

XWAS: Drilled for Injection


20  
8-29-87  
OK16 RCUID 8-13-87

Must be filed with the K.C.C. five (5) days prior to commencing well  
This card void if drilling not started within six (6) months of date received by K.C.C.

**Important procedures to follow:**

1. Notify District office before setting surface casing.
2. Set surface casing by circulating cement to the top.
3. File completion forms ACO-1 with K.C.C. within 120 days of well spud date, following instructions on ACO-1, side 1, and including copies of wireline logs.
4. Notify District office 48 hours prior to old well workover or re-entry.
5. Prior to filing Intent, prepare a proposed plugging plan in case well is D & A, then obtain approval of plan when calling district office prior to setting surface pipe.
6. Submit plugging report (CP-4) to K.C.C. after plugging is completed.
7. Obtain an approved injection docket number before disposing of salt water.
8. Notify K.C.C. within 10 days when injection commences or terminates.
9. If an alternate 2 completion, cement in the production pipe from below any usable water to surface within 120 days of spud date.

**A Regular Section of Land  
1 Mile = 5,280 Ft.**

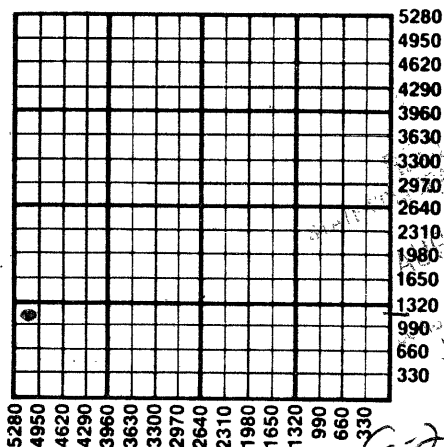

State Corporation Commission of Kansas  
Conservation Division  
200 Colorado Derby Building  
Wichita, Kansas 67202-1212  
(316) 263-3238