

CARD MUST BE TYPED

State of Kansas
NOTICE OF INTENTION TO DRILL
(see rules on reverse side)

CARD MUST BE SIGNED

Starting Date: September 19, 1985
month day year

API Number 15- 163-22,741-00-00

OPERATOR: License # 6854

SW SE SW Sec 3 ... Twp 9 ... S, Rge 19 ... East
(location) West

Name ..Sohio..Petroleum..Company.....

Address 50 Penn Place/Suite 1100.....

City/State/Zip ..Oklahoma City, OK.. 73118.....

Contact Person W. C. Koger.....

Phone ...405/848-7571.....

.....330..... Ft North from Southeast Corner of Section
.....3630..... Ft West from Southeast Corner of Section
(Note: Locate well on Section Plat on reverse side)

CONTRACTOR: License # 5418

Name ..Allen Drilling Company.....

City/State Great Bend, Kansas.....

Nearest lease or unit boundary line ...330..... feet.

County ...Rooks.....

Lease Name Rostocil..... Well# ..A-7.....

Domestic well within 330 feet : yes no

Municipal well within one mile : yes no

Well Drilled For: Well Class: Type Equipment:

Oil Swd Infield Mud Rotary

Gas Inj Pool Ext. Air Rotary

OWWO Expl Wildcat Cable

Depth to Bottom of fresh water350..... feet

Lowest usable water formationDakota.....

Depth to Bottom of usable water570..... 750..... feet

Surface pipe by Alternate : 1 2

Surface pipe to be set ...700..... 750..... feet

Conductor pipe if any requiredNA..... feet

Ground surface elevation2014..... feet MSL

This Authorization Expires2-12-86.....

Approved By8-12-85.....

If OWWO: old well info as follows:

Operator

Well Name

Comp Date Old Total Depth

Projected Total Depth3450..... feet

Projected Formation at TD ..Arbuckle.....

Expected Producing Formations ..Arbuckle.....

I certify that we will comply with K.S.A. 55-101, et seq., plus eventually plugging hole to K.C.C. specifications.

8/8/85

Date Signature of Operator or Agent

BV Jones


District Drilling Supt.

Kd - 455'

Must be filed with the K.C.C. five (5) days prior to commencing well
This card void if drilling not started within six (6) months of date received by K.C.C.

Important procedures to follow :

**A Regular Section of Land
1 Mile = 5,280 Ft.**

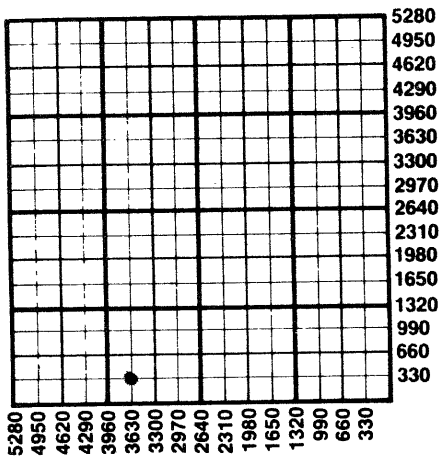

1. Notify District office before setting surface casing.
2. Set surface casing by circulating cement to the top.
3. File completion forms ACO-1 with K.C.C. within 90 days of well completion, following instructions on ACO-1, side 1, and including copies of wireline logs.
4. Notify District office 48 hours prior to old well workover or re-entry.
5. Prior to plugging, prepare a plugging plan, then obtain agreement from the appropriate district office for an approved plugging plan.
6. Submit plugging report (CP-4) to K.C.C. after plugging is completed.
7. Obtain an approved injection docket number before disposing of salt water.
8. Notify K.C.C. within 10 days when injection commences or terminates.
9. If, in alternate completion, cement in the production pipe from below any usable water surface within 120 days of spud date.

RECEIVED
STATE CORPORATION COMMISSION
8/12/85
AUG 12 1985

State Corporation Commission of Kansas
Conservation Division

200 Colorado Derby Building
Wichita, Kansas 67202

(316) 263-3238

CONSERVATION DIVISION
Wichita, Kansas