


STATE OF KANSAS
STATE CORPORATION COMMISSION

WELL PLUGGING RECORD

Give All Information Completely
Make Required Affidavit
Mail or Deliver Report to:
Conservation Division
State Corporation Commission
800 Biting Building
Wichita, Kansas

Rooks County, Sec. 5 Twp. 9S Rge. (E) 19 (W)
Location as "NE/CNW $\frac{1}{4}$ SW $\frac{1}{4}$ " or footage from lines NE $\frac{1}{4}$ NE $\frac{1}{4}$ NE $\frac{1}{4}$
Lease Owner HEATHMAN & CO., et al
Lease Name ONDRASEK "A" Well No. 1
Office Address 509 Orpheum Bldg., Wichita 2, Kansas
Character of Well (completed as Oil, Gas or Dry Hole) dry hole
Date well completed cable tool drilling-in 2-11 19 52
Application for plugging filed 2-18- 19 52
Application for plugging approved 2-20- 19 52
Plugging commenced 2-20 19 52
Plugging completed 2-23 19 52
Reason for abandonment of well or producing formation dry hole

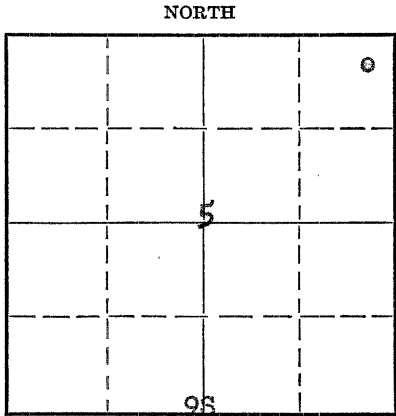

Locate well correctly on above Section Plat

If a producing well is abandoned, date of last production --- 19 ---
Was permission obtained from the Conservation Division or its agents before plugging was commenced? yes

Name of Conservation Agent who supervised plugging of this well Eldon Petty
Producing formation --- Depth to top --- Bottom --- Total Depth of Well 3492 Feet
Show depth and thickness of all water, oil and gas formations.

OIL, GAS OR WATER RECORDS

CASING RECORD

Formation	Content	From	To	Size	Put In	Pulled Out
Arbuckle	water	3480	3492	8-5/8" (set w/125 sacks cement and 1 sack C.C.) 5-1/2" (set w/75 sacks)	164	none

Describe in detail the manner in which the well was plugged, indicating where the mud fluid was placed and the method or methods used in introducing it into the hole. If cement or other plugs were used, state the character of same and depth placed, from --- feet to --- feet for each plug set.

Dumped 4 sacks of cement at 3470'. Shot pipe off at 2959'. Pulled pipe and mudded hole to 164'. Set rock bridge and dumped 15 sacks of cement at 164'. Finished mudding hole and put 10 sacks of cement at top of surface.

3/5/52

(If additional description is necessary, use BACK of this sheet)

Correspondence regarding this well should be addressed to Heathman & Co.
Address 509 Orpheum Bldg., Wichita, Kansas

STATE OF Kansas, COUNTY OF x Reno, ss.
x Bert Self (employee of owner) ~~owner or operator~~ of the above-described well,

being first duly sworn on oath, says: That I have knowledge of the facts, statements, and matters herein contained and the log of the above-described well as filed and that the same are true and correct. So help me God.

(Signature) Bert Self

(Address)

SUBSCRIBED AND SWORN to before me this 3rd day of March, 1952

9/28/55

Bert Self
Notary Public.

PLUGGING
FILE SEC 5 T 9 R 19W
PAGE 147 LINE 26

15-163-02952-00-00

ONDRASEK "A" WELL NO. 1

Location: NE/4 NE/4 ^{NE/4} / Sec. 5-9S-19W
Rooks County, Kansas

Date Spudded: 1-23-52

Operator: Heathman & Co.

Rotary Completed: 2-1-52

Contractor: Walters Drilling Co., Inc. Elevation: 2042 KB

Surface Casing: 5 1/2" set @ 164'
w/125 sacks cement and 1 sack C.C.

Rotary Total Depth: 3484'

Oil String: 5 1/2" set @ 3482'

GEOLOGICAL TOPS

Anhydrite	1465
Topeka	2994
Heebner	3200
Lansing	3240
Base Kansas City	3453
Arbuckle	3480
Rotary Total Depth	3484

L O G

(Figures indicate bottom of formation)

Shale and sand	0 to 164
Shale, shells & sand	959
Sand	1195
Sand & Shale	1235
Shale and lime shells	1465
Anhydrite	1500
Shale and shells	2115
Shale and lime	2573
Lime	2640
Lime and shale	2935
Lime	3035
Lime and shale	3198
Lime	3243
Lime and shale	3480
Dolomite	3484
Total Depth	3484

3/5/52

The undersigned, Robert F. Walters, hereby certifies that the above log is a true and correct log of the formations encountered in drilling the above noted well as reflected by the Daily Drilling Reports.

WALTERS DRILLING CO., INC.

By Robert F. Walters
President

Subscribed and sworn to before me this 6th day of February, 1952.

Ed. Marjorie Mott
Notary Public

My Commission Expires June 28, 1952

PLUGGING
FILE SEC 5 T 9 219W
BOOK PAGE 47 26