

STATE OF KANSAS
STATE CORPORATION COMMISSION


Give All Information Completely
Make Required Affidavit
Mail or Deliver Report to:
Conservation Division
State Corporation Commission
211 No. Broadway
Wichita, Kansas

WELL PLUGGING RECORD

Rooks County. Sec. 30 Twp. 9S Rge. (E) 18W (W)
NW/4 SW/4 NW/4

Location as "NE/CNW/SW" or footage from lines
Lease Owner Grant Oil Company
Lease Name Hilgers "B" No. Well No. 2
Office Address 518 W K H Building, Wichita 2, Kansas
Character of Well (completed as Oil, Gas or Dry Hole) Dry Hole
Date well completed June 29, 19 58
Application for plugging filed (verbally approved) July 1, 19 58
Application for plugging approved (verbally approved) June 29, 19 58
Plugging commenced June 29, 19 58
Plugging completed June 29, 19 58
Reason for abandonment of well or producing formation _____

NORTH

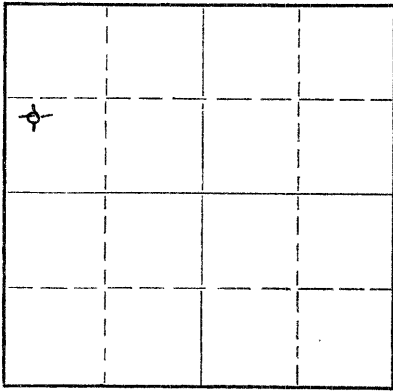

Locate well correctly on above
Section Plat

If a producing well is abandoned, date of last production _____ 19____
Was permission obtained from the Conservation Division or its agents before plugging was commenced? Yes

Name of Conservation Agent who supervised plugging of this well Eldon Petty
Producing formation _____ Depth to top _____ Bottom _____ Total Depth of Well 3650 Feet
Show depth and thickness of all water, oil and gas formations.

OIL, GAS OR WATER RECORDS

CASING RECORD

FORMATION	CONTENT	FROM	TO	SIZE	PUT IN	PULLED OUT
		0	260	8-5/8	260'	None

Describe in detail the manner in which the well was plugged, indicating where the mud fluid was placed and the method or methods used in introducing it into the hole. If cement or other plugs were used, state the character of same and depth placed, from _____ feet to _____ feet for each plug set.

Bottom plug set at 550' with 20 sacks cement mixed and poured through drill pipe.
Middle plug set at 240' with 15 sacks cement mixed and poured.
Top plug set at 40' with 10 sacks cement mixed and poured.

(If additional description is necessary, use BACK of this sheet)
Name of Plugging Contractor Birmingham-Bartlett Drilling Co.
Address 300 Kaufman Building, Wichita 2, Kansas

STATE OF KANSAS, COUNTY OF SEDGWICK, ss.
Richard Hindery, partner of Birmingham-Bartlett Drilling Co., contractor
well, being first duly sworn on oath, says: That I have knowledge of the facts, statements, and matters herein contained and the log of the above-described well as filed and that the same are true and correct. So help me God. BIRMINGHAM-BARTLETT DRILLING CO.

(Signature) Richard Hindery By Richard Hindery
Partner
300 Kaufman Building, Wichita 2, Kansas
(Address)

SUBSCRIBED AND SWORN TO before me this 1st day of July, 19 58.

My commission expires November 29, 1958.

Vivian F. Yinger
Vivian F. Yinger, Notary Public.

7/29/58

PLUGGING
FILE SEC 30 T 9 R 18w
BOOK PAGE 113 LINE 32

HILGERS "B" NO. 2 WELL

LOCATION: NW/4 SW/4 NW/4 Sec. 30-98-18W
Rooks County, Kansas

OWNER and OPERATOR: Grant Oil Company
518 W K H Building
Wichita, Kansas

CONTRACTOR: Birmingham-Bartlett Drilling Co.
300 Kaufman Building
Wichita, Kansas

SURFACE CASING: 8-5/8" Used Casing cemented at 260'
with 185 sacks bulk cement and 3 c.c.

OIL STRING: None Run - Dry, Abandoned and Plugged

SPUDDED: 6-21-58
COMPLETED: 6-29-58

LOG

(Figures indicate bottom of formation)

0 - 260	Shale and Shells
875	Shale
1010	Sand
1050	Shale
1250	Sand
1390	Shale
1560	Shale and Red Bed
1600	Anhydrite
1985	Shale and Red Bed
2350	Shale and Shells
3125	Shale and Lime
3639	Lime
3650	Cherty Arbuckle
3650	Rotary Total Depth - D & A

The undersigned, Richard Hindery, one of the partners of Birmingham-Bartlett Drilling Co., hereby certifies that the above is a true and correct log of the formations encountered in drilling the Hilgers "B" No. 2 Well, as shown in the daily drilling reports.

BIRMINGHAM-BARTLETT DRILLING CO.

By Richard Hindery
Partner

Subscribed and sworn to before
me this 1st day of July, 1958.

Vivian F. Yinger
Vivian F. Yinger, Notary Public

My commission expires November 29, 1958.

7/24/58

PLUGGING			
FILE	SEC	30 T 9 R 18W	
BOOK	PAGE	113	LINE 32