


15-163-02497-00-00

STATE OF KANSAS
STATE CORPORATION COMMISSION

Give All Information Completely
Make Required Affidavit
Mail or Deliver Report to:
Conservation Division
State Corporation Commission
800 Bitting Building
Wichita, Kansas

WELL PLUGGING RECORD

NORTH

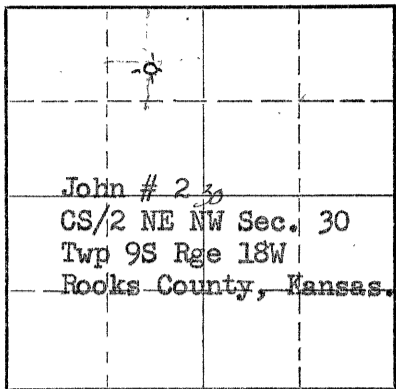

Locate well correctly on above Section Plat

Rooks County, Sec. 30 Twp. 9S Rge. 18 ~~EX~~ W (W)
Location as "NE/CNW/SW" or footage from lines CS/2 NE NW
Lease Owner Heathman & Company
Lease Name John Well No. 2
Office Address 254 N. Washington Wichita, Kansas.
Character of Well (completed as Oil, Gas or Dry Hole) Dry Hole
Date well completed 4-13 19 53
Application for plugging filed 4-13 19 53
Application for plugging approved 4-13 19 53
Plugging commenced 4-13 8:00 A. M. 19 53
Plugging completed 4-14 12:00 Noon 19 53
Reason for abandonment of well or producing formation Dry Hole

If a producing well is abandoned, date of last production _____ 19____
Was permission obtained from the Conservation Division or its agents before plugging was commenced? Yes Verbal

Name of Conservation Agent who supervised plugging of this well Eldon Petty
Producing formation _____ Depth to top _____ Bottom _____ Total Depth of Well 3649 Feet
Show depth and thickness of all water, oil and gas formations.

OIL, GAS OR WATER RECORDS

CASING RECORD

FORMATION	CONTENT	FROM	TO	SIZE	PUT IN	PULLED OUT
Sand, Shells, Blue Shale		0	175	8 5/8	175'	None
Shale & Shells		1630	1945			
Lime & Shale		1945	3360			
Lime		3360	3623			
Arbuckle		3623	3649			
Total Depth		3649				

Describe in detail the manner in which the well was plugged, indicating where the mud fluid was placed and the method or methods used in introducing it into the hole. If cement or other plugs were used, state the character of same and depth placed, from _____ feet to _____ feet for each plug set.

Stirred pits well filled hole with heavy mud set wood plug @ 160'. Ran 1/2 sack hulls and 15 sacks of cement. Filled hole to 40' set wood plug @ 40'. Ran 1/2 sack hulls and 10 sacks of cement filling hole to the bottom of the cellar.

RECEIVED
STATE CORPORATION COMMISSION
9/21/53
WICHITA, KANSAS

Name of Plugging Contractor Strain Drilling Company
Address Box 188 Hays, Kansas.

STATE OF Kansas. COUNTY OF Ellis, ss.
T. C. Strain (employee of owner) or (owner or operator) of the above-described well, being first duly sworn on oath, says: That I have knowledge of the facts, statements, and matters herein contained and the log of the above-described well as filed and that the same are true and correct. So help me God.

(Signature) T. C. Strain
Box 188 Hays, Kansas.
(Address)

SUBSCRIBED AND SWORN to before me this 15th day of April, 19 53
Mildred Schneider

My commission expires March 26, 1956 Notary Public.

PLUGGING
FILE SEC 30 T 9 R 18W
BOOK PAGE 93 LINE 42

15-103-02497-00-00

Well Log

COMPANY: Heathman & Company

CS/2 NE 1/4 Sec. 30
Twp. 9S Rge. 18W
Rooks County, Kansas.

LEASE: JOHN # 2

ELEVATION: 2179 A. D.

NOTE: All Nees Rotary Drilling

0	40 Sand & Shells
40	125 Shale & Shells
125	155 Blue Shale & Shells
155	173 Blue Shale
173	838 Shale & Shells
838	1080 Sand & Shells
1080	1316 Sand
1316	1330 Shale, Shells & Redbed
1330	1355 Shale, Shells & Redbed
1355	1560 Shale & Pyrite
1560	1570 Shale & Redbed
1570	1630 Shale
1630	1910 Shale & Shells
1910	1945 Shale & Shells
1945	2190 Lime & Shale
2190	2300 Shale & lime
2300	2345 Lime & Shale
2345	2400 Lime & Shale
2400	2430 Lime
2430	2615 Lime & Shale
2615	2735 Lime & Shale
2735	2825 Lime & Shale
2825	3005 Shale & lime
3005	3155 Lime
3155	3250 Lime & Shale
3250	3285 Lime & Shale
3285	3344 Lime & Shale
3344	3360 Lime
3360	3405 Lime
3405	3440 Lime
3440	3455 Lime
3455	3500 Lime

3500	3545 Lime
3545	3598 Lime
3598	3623 Lime
3623	3649 Artuckle
3649	(Total Depth)

COMMENCED: 4-3-53
COMPLETED: 4-13-53

CASING RECORD:

8 5/8 Surface Casing set 175' 3/125
sacks of cement by Sun Cementing Co.

D.S.F. by Johnston Testers

3314-3344 Tool Open 1 hour. Recovered 60'
slightly oil & gas cut mud. 60' of oil &
gas cut mud. 60' of heavy oil & gas cut
mud/ 15 min. D.S.F. 1100'

3432-3455 Tool open 1 hour. Recovered 800'
muddy salt water flow pressure 420'.
15 min. D.S.F. 1100'

No Electric logs run

Geologist: Bob Armstrong.

TOTAL

Geologist

Anhydrite	77		Lensing K. G.	3350	(-1171)
Topsoil	3079	(- 928)	Russ K. G.	3545	(-1381)
Heathman	3309	(-1130)	Conglomerate	3598	(-1417)
Toronto	3330	(-1151)	Artuckle	3623	(-1443)
			T. D. 3649	(-1470)	

STATE OF KANSAS) 48
COUNTY OF HELLIS)

I hereby affirm that the above and foregoing is a true and correct copy
of the log of the John # 2, located CS/2 NE 1/4 Sec. 30 Twp 9S, Rge 18W, Rooks County,
Kansas.

PLUGGING
FILE SEC 399 R 18W
BOOK PAGE 98 LINE 42

CONTRACTOR: Hardin Drilling Company

By: [Signature]

Subscribed and sworn to before me this 15th day of April 1953.
My Commission expires March 26, 1956

Michael Schneider
Notary Public.

4/21/53