


WELL PLUGGING RECORD

Give All Information Completely  
Make Required Affidavit  
Mail or Deliver Report to:  
Conservation Division  
State Corporation Commission  
800 Bittling Building  
Wichita, Kansas

Rooks County. Sec. 30 Twp. 9s Rge. 18 (E) W (W)  
Location as "NE/CNW $\frac{1}{4}$ SW $\frac{1}{4}$ " or footage from lines SE $\frac{1}{4}$ , NW $\frac{1}{4}$ , SW $\frac{1}{4}$   
Lease Owner Grant Oil Co.  
Lease Name Sollenberger Well No. 2  
Office Address 814 Central Bldg., Wichita, Kansas.  
Character of Well (completed as Oil, Gas or Dry Hole) dry  
Date well completed Feb. 13, 19 52  
Application for plugging filed June, 20 19 52  
Application for plugging approved June 20, 19 52  
Plugging commenced June 20, 19 52  
Plugging completed June 27, 19 52  
Reason for abandonment of well or producing formation dry

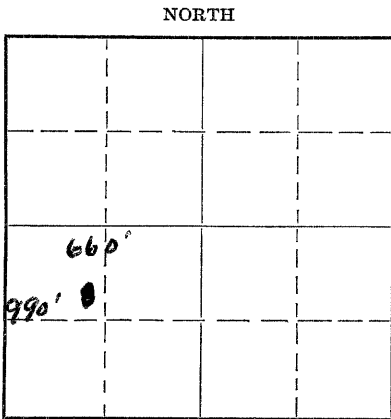

Locate well correctly on above  
Section Plat

If a producing well is abandoned, date of last production no production 19       
Was permission obtained from the Conservation Division or its agents before plugging was commenced? yes

Name of Conservation Agent who supervised plugging of this well Mr. Peddy  
Producing formation Arbuckle Depth to top 3610' Bottom 3620' Total Depth of Well 3620' Feet  
Show depth and thickness of all water, oil and gas formations.

OIL, GAS OR WATER RECORDS

CASING RECORD

Formation	Content	From	To	Size	Put In	Pulled Out
Arbuckle	water	0	3620	5 1/2	3610	1333

Describe in detail the manner in which the well was plugged, indicating where the mud fluid was placed and the method or methods used in introducing it into the hole. If cement or other plugs were used, state the character of same and depth placed, from      feet to      feet for each plug set.

Filled hole with sand from 3620' up to 3610'. Dumped 4 sacks of cement.  
Filled hole with mud from 1240' to 280'. Put in 10 ft. rock bridge. Mixed and run 15 sacks of cement. Filled hole with mud from 225' up to 35'. Put in 5 ft. of rock bridge. Mixed and ran 10 sacks of cement. Filled surface pipe to bottom of cellar, wich was 5 ft. below surface.

7/10/52  
CONSERVATION DIVISION  
Wichita, Kansas

(If additional description is necessary, use BACK of this sheet)

Correspondence regarding this well should be addressed to Grant Oil Co.  
Address 814 Central Bldg.  
Wichita, Kansas

STATE OF Kansas, COUNTY OF Rooks, ss.  
I, Paul Pfeifer (employee of owner) or (owner or operator) of the above-described well, being first duly sworn on oath, says: That I have knowledge of the facts, statements, and matters herein contained and the log of the above-described well as filed and that the same are true and correct. So help me God.

(Signature) Paul Pfeifer

SUBSCRIBED AND SWORN to before me this 8th day of July, 19 52

(Address) Wichita, Kansas  
Notary Public.

My commission expires     

PLUGGING  
FILE SEC 30 79 R180  
BOOK PAGE 27 LINE 26

SOLLENBERGER NO. 2

SE/4 NW/4 SW/4 30-9S-18W, Rooks County, Kansas

Rigging up Rotary Tools 1/29/51  
 Tearing down Rotary Tools 2/11/51  
 Rigging Cable Tools 2/27/51  
 Tearing down Cable Tools 3/1/51


Run 7 Jts. 280' of 8 5/8" surface pipe.  
 Set @ 280' and cemented with 150 sx  
 Cement.  
 Run 114 Jts. 3627' of 5 1/2" casing.  
 Set at 3617' and cemented with 100  
 sx cement.

Formation	From	To
Sand and shale	0	280
Shale and shells	280	700
Sand	700	780
Shale, redbed, shells	780	904
Sand and shale	904	1100
Sand	1100	1310
Shale and redbed	1310	1380
Shale, Shells, Redbed	1380	1550
Anhydrite	1550	1605
Pyrite and shale	1605	1633
Shale and shells	1633	1650
Salt, shale and redbed shells	1650	1796
Shale and shells	1796	2045
Lime and shale	2045	3390
Lime	3390	3424
Lime and shale	3424	3461
Lime	3461	3561
Lime and shale	3561	3614
Arbuckle	3614	3622 Total Depth

I, W. A. Grant, hereby certify that the above Log is true and correct,  
 to the best of my knowledge and belief.



Subscribed and sworn to before me this 9th day of July, 1952.

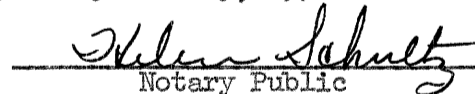  
 Notary Public

My commission expires: Feb. 29, 1956.

STATE

7/10/52

**PLUGGING**  
 FILE SEC 301-9-R-SPC  
 BOOK PAGE 27 LINE 26