


WELL PLUGGING RECORD

Give All Information Completely  
Make Required Affidavit  
Mail or Deliver Report to:  
Conservation Division  
State Corporation Commission  
800 Bittig Building  
Wichita, Kansas

Rooks County, Sec. 31 Twp. 9 Rge. (E) 18 (W)

Location as "NE/CNW/SW" or footage from lines NW NW SW  
Lease Owner Jones, Shelburne & Farmer, Inc.  
Lease Name Baumgartner Well No. 1  
Office Address Russell, Kansas  
Character of Well (completed as Oil, Gas or Dry Hole) Dry  
Date well completed 6-3 19 55  
Application for plugging filed 6-3 19 55  
Application for plugging approved 6-3 19 55  
Plugging commenced 6-3 19 55  
Plugging completed 6-3 19 55  
Reason for abandonment of well or producing formation Dry

NORTH

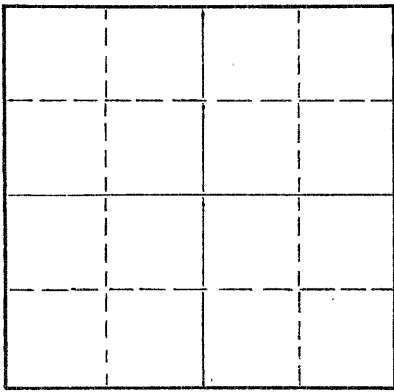

Locate well correctly on above  
Section Plat

If a producing well is abandoned, date of last production \_\_\_\_\_ 19\_\_\_\_  
Was permission obtained from the Conservation Division or its agents before plugging was commenced? Yes

Name of Conservation Agent who supervised plugging of this well Eldon Petty  
Producing formation \_\_\_\_\_ Depth to top \_\_\_\_\_ Bottom \_\_\_\_\_ Total Depth of Well 3760 Feet  
Show depth and thickness of all water, oil and gas formations.

OIL, GAS OR WATER RECORDS

CASING RECORD

FORMATION	CONTENT	FROM	TO	SIZE	PUT IN	PULLED OUT
				8-5/8"	155	None

Describe in detail the manner in which the well was plugged, indicating where the mud fluid was placed and the method or methods used in introducing it into the hole. If cement or other plugs were used, state the character of same and depth placed, from \_\_\_\_\_ feet to \_\_\_\_\_ feet for each plug set.

1. Filled hole with heavy mud
2. Pushed plug to 150'
3. Dumped 1/2 sack hulls on top of plug
4. Mixed 15 sacks cement and dumped on top of hulls
5. Filled hole to top
6. Pushed plug to 40'
7. Dumped ;in 1/2 sack hulls
8. Mixed 10 sacks cement and filled hole to top with same.

6/11/55

(If additional description is necessary, use BACK of this sheet)

Name of Plugging Contractor Jones, Shelburne & Farmer, Inc.  
Address Russell, Kansas

STATE OF Kansas, COUNTY OF Russell, ss.  
JOHN O. FARMER (employee of owner) or (owner or operator) of the above-described well, being first duly sworn on oath, says: That I have knowledge of the facts, statements, and matters herein contained and the log of the above-described well as filed and that the same are true and correct. So help me God.

(Signature) John O. Farmer  
Russell, Kansas (Address)

SUBSCRIBED AND SWORN TO before me this 8th day of June, 19 55

Lucille Fausch Notary Public.

My commission expires October 11, 1958

PLUGGING  
FILE SEC 31 T 9 R 18W  
BOOK PAGE 124 LINE 34

OPERATOR Jones, Shelburne & Farmer, Inc.

15-163-00840-00-00


FORMATION RECORD

ADDRESS Russell, Kansas

Give detailed description and thickness of all formations drilled through, contents of sand, whether dry, water, oil or gas.

FARM NAME Baumgartner, WELL NO. 1, COUNTY ROOF, SEC. 31, TWP. 9, RGE. 18

640 Acres  
N

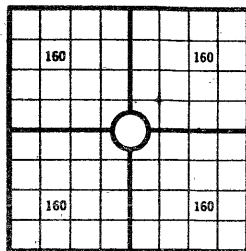

Locate well correctly

COUNTY Rooks, SEC. 31, TWP. 9, RGE. 18  
 COMPANY OPERATING Jones, Shelburne & Farmer, Inc.  
 OFFICE ADDRESS Russell, Kansas  
 FARM NAME Baumgartner WELL NO. 1  
 DRILLING STARTED 5-25, 1955, DRILLING FINISHED 6-3, 1955  
 DATE OF FIRST PRODUCTION \_\_\_\_\_ COMPLETED \_\_\_\_\_  
 WELL LOCATED NW 1/4 NW 1/4 SW 1/4, North of South  
 Line and \_\_\_\_\_ ft. East of West Line of Quarter Section  
 Elevation (Relative to sea level) DERRICK FLOOR 2199 GROUND 2194  
 CHARACTER OF WELL (Oil, gas or dryhole) Dry

Formation	Top	Bottom	Formation	Top	Bottom
Sand & shale	0	153			
Shale & shells	153	255			
Shale & sand streaks	255	1065			
Sand	1065	1105			
Shale & sand	1105	1250			
Shale & Redbed	1250	1608			
Anhydrite	1608	1642			
Shale & shells	1642	2020			
Shale & lime	2020	2365			
Lime & shale	2365	2880			
Shale & lime	2880	3365			
Lime & shale	3365	3585			
Lime	3585	3664			
Lime & shale	3664	3706			
Arbuckle	3706	3760			
R.T.D.		3760			

6/11/55

TOPS:

Elevation	RB	
Heeber		2201
Toronto		3368
Lansing		3386
Base Kansas City		3409
Conglomerate		3623
Arbuckle		3646
		3704
R.T.D.		3760

**PLUGGING**  
 FULL SEC 31, 9 R 18W  
 PAGE 24 - LINE 37  
 BOOK

OIL OR GAS SANDS OR ZONES

Name	From	To	Name	From	To
1			4		
2			5		
3			6		

Perforating Record If Any

Shot Record

Formation	From	To	No. of Shots	Formation	From	To	Size of Shot

CASING RECORD

Amount Set								Amount Pulled		Packer Record	
Size	Wt.	Thds.	Make	Ft.	In.	Ft.	In.	Size	Length	Depth Set	Make
8-5/8				155							

Liner Record: Amount \_\_\_\_\_ Kind \_\_\_\_\_ Top \_\_\_\_\_ Bottom \_\_\_\_\_

CEMENTING AND MUDDING

Size	Amount Set		Sacks Cement	Chemical		Method of Cementing	Amount	Mudding Method	Results (See Note)
	Ft.	In.		Gal.	Make				
8-5/8	155		100						

Note: What method was used to protect sands if outer strings were pulled? \_\_\_\_\_

NOTE: Were bottom hole plugs used? \_\_\_\_\_ If so, state kind, depth set and results obtained \_\_\_\_\_

TOOLS USED

Rotary Tools were used from \_\_\_\_\_ feet to \_\_\_\_\_ feet. Cable tools were used from \_\_\_\_\_ feet to \_\_\_\_\_ feet, and from \_\_\_\_\_ feet to \_\_\_\_\_ feet, and from \_\_\_\_\_ feet to \_\_\_\_\_ feet.

Type Rig \_\_\_\_\_

INITIAL PRODUCTION TEST

Describe initial test: whether by flow through tubing or casing or by pumping \_\_\_\_\_

Amount of Oil Production \_\_\_\_\_ bbls. Size of choke, if any \_\_\_\_\_ Length of test \_\_\_\_\_ Water

Production \_\_\_\_\_ bbls. Gravity of oil \_\_\_\_\_ Type of Pump if pump is used, describe \_\_\_\_\_

I, the undersigned, being first duly sworn upon oath, state that this well record is true, correct and complete according to the records of this office and to the best of my knowledge and belief.

*John Farmer* Vice-Pres.  
Name and title of representative of company

Subscribed and sworn to before me this 8th day of June, 1955  
 My Commission expires 10-11-58  
*Lucille Kennedy*  
 Notary Public