


STATE OF KANSAS
STATE CORPORATION COMMISSION

WELL PLUGGING RECORD

Give All Information Completely
Make Required Affidavit
Mail or Deliver Report to:
Conservation Division
State Corporation Commission
P. O. Box 17027
Wichita, Kansas 67217
NORTH

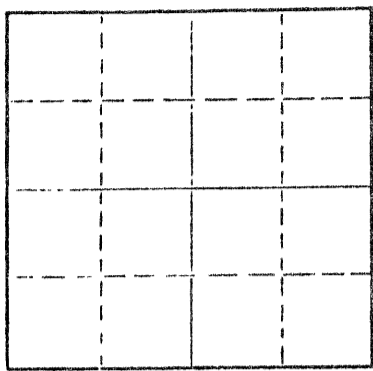

Locate well correctly on above
Section Plat

Rooks County, Sec. 31 Twp. 9S Rge. 18 (W)
Location as "NE/CNW&SWW" or footage from lines NW SE NE
Lease Owner Edmiston Oil Co., Inc.
Lease Name PYWELL Well No. 2
Office Address 800 Vickers-KSB&T Bldg., Wichita, KS 67202
Character of Well (completed as Oil, Gas or Dry Hole) dry hole
Date well completed Sept. 28, 1978
Application for plugging filed (verbally) Sept. 28, 1978
Application for plugging approved (verbally) Sept. 28, 1978
Plugging commenced Sept. 28, 1978
Plugging completed Sept. 28, 1978
Reason for abandonment of well or producing formation dry hole - no commercial quantity of oil or gas encountered
If a producing well is abandoned, date of last production 19
Was permission obtained from the Conservation Division or its agents before plugging was commenced? yes

Name of Conservation Agent who supervised plugging of this well Leo Massey, Hays, Kansas
Producing formation Depth to top Bottom Total Depth of Well 3775 feet
Show depth and thickness of all water, oil and gas formations.

OIL, GAS OR WATER RECORDS

CASING RECORD

FORMATION	CONTENT	FROM	TO	SIZE	PUT IN	PULLED OUT
				8-5/8"	201	none

Describe in detail the manner in which the well was plugged, indicating where the mud fluid was placed and the method or methods used in introducing it into the hole. If cement or other plugs were used, state the character of same and depth placed, from feet to feet for each plug set.

Set 1st plug at 600' with 70 sacks
2nd plug at 180' with 20 sacks
solid plug at 40' with 10 sacks
Cemented with 50/50 posmix, 6% gel

RECEIVED
STATE CORPORATION COMMISSION
11/20/78
NOV 20 1978

(If additional description is necessary, use BACK of this sheet)
Name of Plugging Contractor Sun Oilwell Cementing, Inc.
Address Box 169, Great Bend, Kansas 67530

CONSERVATION DIVISION
Wichita, Kansas

STATE OF Kansas COUNTY OF Sedgwick ss. Robt K. Edmiston

Robt K. Edmiston (owner or operator) of the above-described well, being first duly sworn on oath, says: That I have knowledge of the facts, statements, and matters herein contained and the log of the above-described well as filed and that the same are true and correct. So help me God.

(Signature) Robt K. Edmiston
800 Vickers-KSB&T Bldg., Wichita, KS (Address)

SUBSCRIBED AND SWORN TO before me this 14th day of November, 1978

My commission expires November 14, 1981

Marilyn E. Fox
Marilyn E. Fox Notary Public.



DRILLERS LOG

15-163-20852-00-00

Well Name Pywell #2

Company Edmiston Oil Co. Inc.

Casing Record
8 5/8" @ 202'
150 Sack Cement

Contractor Tornado Drilling Co., Inc.

Starting Date 9-19-78

Completed Date 9-28-78

Description:
NW-SE-NE
Sec. 31-9S-18W
Rooks County, KS

Total Depth 3775' Plugged & Abandon

Elevation Unknown

Formation	From	To	Remarks
Shale & Sand	0	850	
Sand	850	1002	
Shale	1002	1435	
Red Shale	1435	1530	
Anhydrite	1530	1550	
Shale & Sand Streaks	1550	2050	
Shale	2050	2100	
Shale & Lime	2100	2903	
Shale	2903	3115	
Lime & Shale	3115	3775	
T. D.		3775	

RECEIVED
STATE CORPORATION COMMISSION
10/4/78
OCT - 4 1978

CONSERVATION DIVISION
Wichita, Kansas

STATE OF Oklahoma


County of Garfield

I do certify that this is a true and correct copy of the above log to the best of my knowledge.

TORNADO DRILLING COMPANY, INC.


Boyd Phillips

Subscribed and sworn to before me the 3rd day of October, 1978.

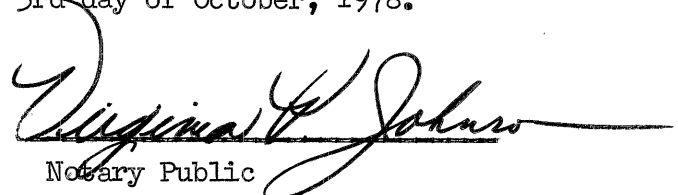
Notary Public