


STATE OF KANSAS
STATE CORPORATION COMMISSION

Give All Information Completely
Make Required Affidavit
Mail or Deliver Report to:
Conservation Division
State Corporation Commission
800 Bittling Building
Wichita, Kansas

WELL PLUGGING RECORD

Rooks County. Sec. 21 Twp. 9 Rge. 18 (X) (W)
Location as "NE/CNW $\frac{1}{4}$ SW $\frac{1}{4}$ " or footage from lines NW SE SE
Lease Owner John B. Hawley, Jr.
Lease Name Rempe Well No. 1
Office Address Columbia Heights, P.O. Minneapolis 13, Minn.
Character of Well (completed as Oil, Gas or Dry Hole) Dry Hole
Date well completed March 4 1949
Application for plugging filed March 23 1949
Application for plugging approved March 24 1949
Plugging commenced March 26 1949
Plugging completed April 12 1949
Reason for abandonment of well or producing formation Dry

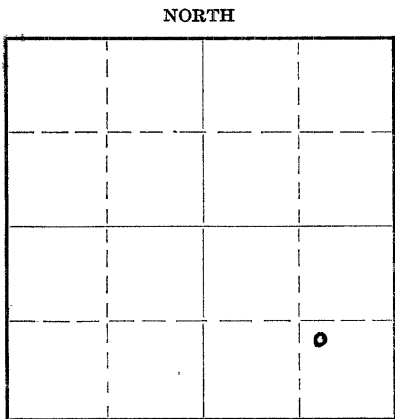

Locate well correctly on above Section Plat

If a producing well is abandoned, date of last production 19
Was permission obtained from the Conservation Division or its agents before plugging was commenced? Yes

Name of Conservation Agent who supervised plugging of this well Eldon R. Petty
Producing formation Depth to top Bottom Total Depth of Well Feet
Show depth and thickness of all water, oil and gas formations.


OIL, GAS OR WATER RECORDS

CASING RECORD

Formation	Content	From	To	Size	Put In	Pulled Out
				8-5/8"	182	None
				5 1/2"	3581	425'

Describe in detail the manner in which the well was plugged, indicating where the mud fluid was placed and the method or methods used in introducing it into the hole. If cement or other plugs were used, state the character of same and depth placed, from feet to feet for each plug set.

Filled hole with gravel to 3575'. Dumped 5 sacks of cement,
Filled hole with heavy mud to 182', placed 15 sacks of cement,
Filled hole to 35' with heavy mud and placed 10 sacks of
cement which filled up to bottom of cellar.

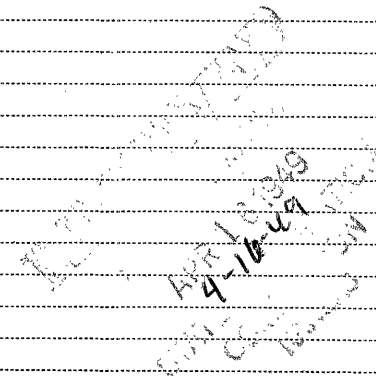

(If additional description is necessary, use BACK of this sheet)

Correspondence regarding this well should be addressed to Chas. J. Beu
Address 1910 Broadway, Great Bend, Kansas

STATE OF Kansas, COUNTY OF Barton, ss.
Chas. J. Beu (employee of owner) or (owner or operator) of the above-described well,
being first duly sworn on oath, says: That I have knowledge of the facts, statements, and matters herein contained and the log of the above-described well as filed and that the same are true and correct. So help me God.

(Signature) Chas. J. Beu

(Address)

SUBSCRIBED AND SWORN to before me this 15th day of April, 1949

My commission expires March 17, 1952. Eldon M. Jorgensen Notary Public.

PLUGGING
FILE SEC 21 T 9 R 18a
BOOK PAGE 88 LINE 5

W. L. Hartman, Contractor
 Box 54
 Wichita, Kansas

JOHN B. HAWLEY, JR.
 Rempe #1
 NW SE SE Sec. 21-9-18W
 Rooks County, Kansas

Elevation D.F. 2160'

TOTAL DEPTH: 3591'
 Commenced: 1-8-49
 Completed:
 Casing: 8-5/8" -- 182' -- with 125 sacks of cement.

Figures indicate bottom of formation:

0	to	20	Clay	
20		80	Shale	
80		100	Shale	
100		180	Shale	
180		345	Shale	
345		680	Shale	
680		1040	Sand and Shale	
1040		1235	Sand	
1235		1290	Shale	
1290		1490	Shale and Shells	
1490		1551	Anhydrite	
1551		1955	Shale and Shells	
1955		1980	Shale	
1980		2150	Lime and Shale	
2150		2270	Shale and Shells	
2270		2380	Lime	
2380		2525	Lime and Shale	
2525		2608	Lime	
2608		2685	Lime	
2685		2795	Lime	
2795		2924	Lime	
2924		2995	Lime	
2995		3080	Lime and Shale	
3080		3150	Lime	
3150		3235	Lime	
3235		3303	Lime	
3303		3344	Lime	
3344		3397	Lime	TOPS:
3397		3451	Lime	Topeka 3072 - 912
3451		3490	Lime	Heebner 3289 -1129
3490		3555	Lime	Lansing K.C. 3326 -1166
3555		3584	Lime and Shale	Arbuckle 3580 -1420
3584		3591	Arbuckle Lime	Total Depth 3591 -1431
		3591	TOTAL DEPTH	

3-24-49

