


STATE OF KANSAS
STATE CORPORATION COMMISSION

Give All Information Completely
Make Required Affidavit
Mail or Deliver Report to:
Conservation Division
State Corporation Commission
212 North Market, Insurance Bldg.
Wichita, Kansas

WELL PLUGGING RECORD

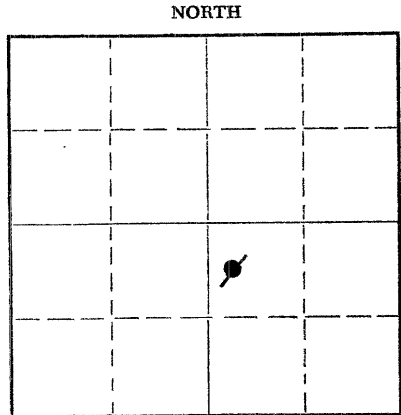

Locate well correctly on above
Section Plat

Rooks County, Sec. 21 Twp. 9 Rge. (E) 18 (W)
Location as "NE/CNW%SW%" or footage from lines C E 1/2 NW 1/4 SE 1/4
Lease Owner Robinowitz Oil Company
Lease Name Rempe Well No. 2
Office Address 6650 S. Lewis, Tulsa, OK 74136
Character of Well (completed as Oil, Gas or Dry Hole) Oil
Date well completed June 10 19 47
Application for plugging filed 19
Application for plugging approved September 28 19 82
Plugging commenced August 27 19 82
Plugging completed October 1 19 82
Reason for abandonment of well or producing formation mechanical problems -
unable to recover tubing stuck in well
If a producing well is abandoned, date of last production March 19 75
Was permission obtained from the Conservation Division or its agents before plugging was com-
menced? Yes

Name of Conservation Agent who supervised plugging of this well Dennis Hamel
Producing formation Toronto & L.-K.C. Depth to top 3304' Bottom 3484' Total Depth of Well 3579 Feet
Show depth and thickness of all water, oil and gas formations.

OIL, GAS OR WATER RECORDS

CASING RECORD

FORMATION	CONTENT	FROM	TO	SIZE	PUT IN	PULLED OUT
Topeka	Water	3076	3285	8 5/8	158	-----
Toronto	Oil/Water	3304	3317	5 1/2	3572	-----
Lansing-Kansas City	Oil/Water	3326	3502	4 1/2	3170	-----
Arbuckle	Oil/Water	3572	T.D.			

Describe in detail the manner in which the well was plugged, indicating where the mud fluid was placed and the method or methods used in introducing it into the hole. If cement or other plugs were used, state the character of same and depth placed, from _____ feet to _____ feet for each plug set.

Mixed 5 sacks cottonseed hulls with 260 sacks cement - pumped down 4 1/2" and shut in with 400 lbs. pressure.

Mixed 1 sack hulls with 90 sacks cement - pumped down 8 5/8" - 5 1/2" annulus. Shut in with 300 lbs. pressure.

WOC, cut off pipe and restore location.

RECEIVED
STATE CORPORATION COMMISSION

OCT 08 1982

10-8-82
CONSERVATION DIVISION
WICHITA, KANSAS

(If additional description is necessary, use BACK of this sheet)

Name of Plugging Contractor Allied Cementing Company, Inc.
Address Box 31, Russell, Kansas 67665

STATE OF Oklahoma, COUNTY OF Tulsa, ss.
Charles E. Son (employee of owner) or (owner or operator) of the above-described

well, being first duly sworn on oath, says: That I have knowledge of the facts, statements, and matters herein contained and the log of the above-described well as filed and that the same are true and correct. So help me God.

(Signature) Charles E. Son
6650 S. Lewis, Tulsa, OK 74136
(Address)

SUBSCRIBED AND SWORN TO before me this 5th day of October, 1982

Carolyn Anderson
Notary Public.

My commission expires April 12, 1986

