

STATE OF KANSAS
STATE-CORPORATION COMMISSION

Give All Information Completely
Make Required Affidavit
Mail or Deliver Report to:
Conservation Division
State Corporation Commission
800 Bitting Building
Wichita, Kansas

WELL PLUGGING RECORD

Rooks County. Sec. 21 Twp. 9S Rge. 18 (E) (W)

Location as "NE/CNW 1/4 SW 1/4" or footage from lines SE SW NW

Lease Owner D. A. Von Feldt

Lease Name Stahl Well No. 1

Office Address c/o Farmers Store Gorham, Kansas

Character of Well (completed as Oil, Gas or Dry Hole) Dry Hole

Date well completed Feb. 4 1951

Application for plugging filed Feb. 4 1951

Application for plugging approved Feb. 4 1951


Plugging commenced Feb. 4 1951

Plugging completed Feb. 4 1951

Reason for abandonment of well or producing formation Dry Hole

If a producing well is abandoned, date of last production 19

Was permission obtained from the Conservation Division or its agents before plugging was commenced? Yes

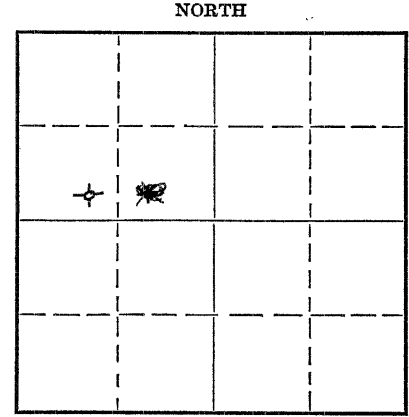

Locate well correctly on above Section Plat

Name of Conservation Agent who supervised plugging of this well E. R. Petty

Producing formation Depth to top Bottom Total Depth of Well 3603 Feet

Show depth and thickness of all water, oil and gas formations.

OIL, GAS OR WATER RECORDS

CASING RECORD

Formation	Content	From	To	Size	Put In	Pulled Out
		0	180'	8 5/8"	180'	None

Describe in detail the manner in which the well was plugged, indicating where the mud fluid was placed and the method or methods used in introducing it into the hole. If cement or other plugs were used, state the character of same and depth placed, from feet to feet for each plug set.

- 3603' - 181 1/2' - Heavy Rotary Mud
- 181 1/2' - 180' - Wooden Plug
- 180' - 134' - 15 Sacks Cement
- 134' - 36 1/2' - Heavy Rotary Mud
- 36 1/2' - 35' - Wooden Plug
- 35' - 6' - 10 Sacks Cement
- 6' - Surface - Cellar

RECEIVED
STATE CORPORATION COMMISSION
2-10-51
FEB 10 1951
CONSERVATION DIVISION
Wichita, Kansas

(If additional description is necessary, use BACK of this sheet)

Correspondence regarding this well should be addressed to D. A. Von Feldt
Address c/o The Farmers Store, Gorham, Kansas

STATE OF Kansas COUNTY OF Barton ss.
Peel Brothers, Inc. (employee of owner) or (conservator) of the above-described well,

being first duly sworn on oath, says: That I have knowledge of the facts, statements, and matters herein contained and the log of the above-described well as filed and that the same are true and correct. So help me God. PEEL BROTHERS, INC.

(Signature) By: *Mendell L. Peel*

161 WEST SECOND, GORHAM, KANSAS (Address)

SUBSCRIBED AND SWORN to before me this 8th day of February, 1951

My commission expires June 4, 1951 Notary Public.

PLUGGING
FILE SEC 21 T 9 R 18W
BOOK PAGE 59 LINE 43

DRILLER'S LOG

Company: D. A. Von Feldt

SE SW NW
Sec. 21 Twp. 9S Rge. 18W

Farm: Stahl Well No. 1

Total Depth: 3603'

County: Rooks,
Kansas

Comm: 1-24-51 Comp: 2-4-51

Contractor: Peel Brothers, Inc.

Elevation:

Casing: 8 5/8" 180' Cem.

Production: Dry

Figures below indicate bottom formations

S&S and sand	0 -	40
Shale & shells		130
Shale		300
Shale & shells		775
Shale, Shells & sand		1475
Shale		1498
Anhydrite		1537
Shale & shells		1995
Shale & lime shells		2075
Lime & shale		2350
Lime		2510
Lime & shale		2665
Lime		2750
Shale & Lime		3210
Lime		3597
Dolomite		3603
Total Depth		3603

This is to certify that the above information is, to the best of our knowledge true and correct.

PEEL BROTHERS, Inc.

By: *Mendell C. Peel*

SUBSCRIBED AND SWORN to before me this 8th day of February, 1951.

My commission expires June 4, 1951 *Manion M. Herbst*
Notary Public

FILED
STATE OF KANSAS
2-10-51
FEB 10 1951
COUNTY OF ROOKS
NOTARY PUBLIC

PLUGGING
FILE SEC 21 9 R 18W
BOOK PAGE 59 LINE 43