


STATE OF KANSAS
STATE CORPORATION COMMISSION

WELL PLUGGING RECORD

Give All Information Completely
Make Required Affidavit
Mail or Deliver Report to
Conservation Division
State Corporation Comm.
245 North Water
Wichita, KS 67202

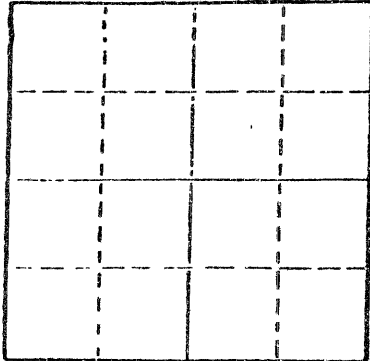

Locate well correctly on above
Section Plat

Rooks County. Sec. 32 Twp. 9S Rge. 19 ~~W~~
Location as "NE/CNW¹/₄SW¹/₄" or footage from lines
SE/4 NE/4 NE/4
Lease Owner Lehsack Oil Production, Inc.
Lease Name Allphin Well No. #1
Office Address P.O. Box 489, Hays, Kansas 67601
Character of Well (Completed as Oil, Gas or Dry Hole)
Dry Hole
Date Well completed 1-8 1982
Application for plugging filed 1-8 1982
Application for plugging approved 1-8 1982
Plugging commenced 1-8 1982
Plugging completed 1-8 1982
Reason for abandonment of well or producing formation
Dry Hole

If a producing well is abandoned, date of last production 19.

Was permission obtained from the Conservation Division or its agents before plugging was commenced? Yes

Name of Conservation Agent who supervised plugging of this well Gilbert Scheck
Producing formation _____ Depth to top _____ Bottom _____ Total Depth of Well _____
Show depth and thickness of all water, oil and gas formations.

OIL, GAS OR WATER RECORDS

CASING RECORD

FORMATION	CONTENT	FROM	TO	SIZE	PUT IN	PULLED OUT
				8-5/8"	265'	-0-

Describe in detail the manner in which the well was plugged, indicating where the mud fluid was placed and the method or methods used in introducing it into the hold. If cement or other plugs were used, state the character of same and depth placed, from _____ feet to _____ feet for each plug set.

Mud laden fluid 3780' to 1020'
70 sx cement @ 1020'
40 sx cement @ 200'
10 sx cement @ 40'
10 sx cement in Rat Hole

(If additional description is necessary, use BACK of this sheet)

Name of Plugging Contractor Ranger Drilling Company, Inc.

RECEIVED
STATE CORPORATION COMMISSION

JAN 18 1982
1-18-82

CONSERVATION DIVISION
Wichita, Kansas


STATE OF KANSAS COUNTY OF ELLIS
Robert R. Price (employee of owner) or (owner or operator)
of the above-described well, being first duly sworn on oath, says: That I have knowledge of the facts, statements, and matters herein contained and the log of the above-described well as filed and that the same are true and correct. So help me God.

(Signature) Robert R. Price mlk
P.O. Box 856, Hays, Kansas 67601
(Address)

SUBSCRIBED AND SWORN TO before me this 12th day of January, 1982

Mary L. Kehn
Notary Public.

My commission expires 8-6-85

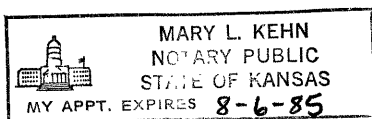

RANGER DRILLING COMPANY, INC.

P.O. Box 856
 Hays, Kansas 67601
 913/625-4210

OPERATOR: Lebsack Oil Production, Inc.
 Box 489
 Hays, Kansas 67601

CONTRACTOR: Ranger Drilling Company, INC.
 P.O. Box 856
 Hays, Kansas 67601

LEASE: Allphin WELL: #1

LOCATION: SE/4 NE/4 NE/4
 Section 32-9S-19W
 Rooks County, Kansas

Total Depth: 3780'

Elevation: 2229 GL

Commenced: 12-29-81

Completed: 1-8-82

Casing: 8-5/8" @ 265'

Status: Dry Hole

DEPTHS & FORMATIONS

(All Measurements from K.B.)

Shale	880	Lime & shale	3085
Shale & sand	1630	Shale & lime	3385
Lime & shale	1836	Lime & shale	3760
Shale, shells & sand	2104	Shale & lime	T.D.
Lime & shale	2620		
Shale & lime	2850		

STATE OF KANSAS)
) ss.
 COUNTY OF ELLIS)

I, Robert R. Price, of the Ranger Drilling Company, Inc., state that the above and foregoing is a true and correct log of the above captioned well.

Robert R. Price mlk
 Robert R. Price

Subscribed and sworn to before me this 12th day of January, 1982.

My Commission Expires:

Mary L. Kehm
 Notary Public

