


Give All Information Completely
Make Required Affidavit
Mail or Deliver Report to:
Conservation Division
State Corporation Commission
211 No. Broadway
Wichita, Kansas

WELL PLUGGING RECORD

Rooks County, Sec. 32 Twp. 9 Rge. 19W(E) (W)

NORTH

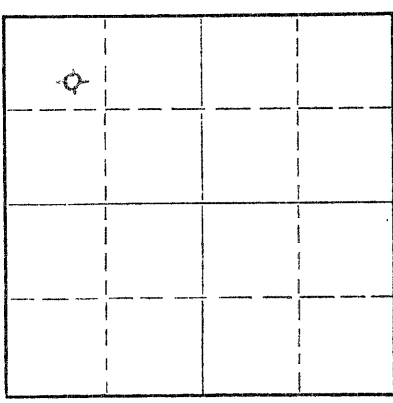

Locate well correctly on above
Section Plat

Location as "NE/CNW/SW" or footage from lines _____
Lease Owner I. O. Miller
Lease Name Alphin "B" Well No. 1
Office Address Box 274, Ells, Kansas
Character of Well (completed as Oil, Gas or Dry Hole) Dry Hole
Date well completed October 20 1962
Application for plugging filed October 20 1962
Application for plugging approved October 20 1962
Plugging commenced October 20 1962
Plugging completed October 20 1962
Reason for abandonment of well or producing formation Too low structurally

If a producing well is abandoned, date of last production _____ 19____
Was permission obtained from the Conservation Division or its agents before plugging was commenced? Yes

Name of Conservation Agent who supervised plugging of this well Eldon Petty, Hays, Kansas
Producing formation _____ Depth to top _____ Bottom _____ Total Depth of Well 3739 Feet
Show depth and thickness of all water, oil and gas formations.

OIL, GAS OR WATER RECORDS

CASING RECORD

FORMATION	CONTENT	FROM	TO	SIZE	PUT IN	PULLED OUT
				8-5/8"	177.39'	none

Describe in detail the manner in which the well was plugged, indicating where the mud fluid was placed and the method or methods used in introducing it into the hole. If cement or other plugs were used, state the character of same and depth placed, from _____ feet to _____ feet for each plug set.

Filled hole with heavy mud to 550'. Set plug. Put in 20 sks. cement.
Filled with heavy mud to 170'. Set Plug
Put in 20 sacks cement. Filled with mud up to 40'. Set plug. Filled to top with one sack hulls and 10 sacks cement.

11-19-62
107-13-1562

CONSERVATION DIVISION
Wichita, Kansas


(If additional description is necessary, use BACK of this sheet)
Name of Plugging Contractor C-G Drilling Co.
Address 107 Rule Building, Wichita 2, Kansas

STATE OF KANSAS, COUNTY OF SEDGWICK, ss.
G. F. GALLOWAY (employee of owner) or (owner or operator) of the above-described well, being first duly sworn on oath, says: That I have knowledge of the facts, statements, and matters herein contained and the log of the above-described well as filed and that the same are true and correct. So help me God.

(Signature) G. F. Galloway
107 Rule Building
(Address)

SUBSCRIBED AND SWORN TO before me this 24 day of October, 1962

My commission expires May 20, 1963
Vicky Jacobs Notary Public.

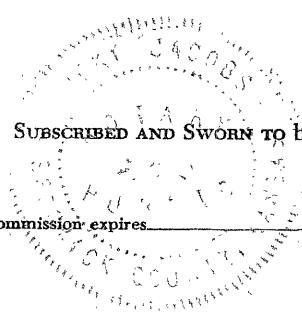

WELL LOG

15-163-01045-00-00

OPERATOR	I. O. Miller	SEC.	32-9-19
WELL NAME	Allphin "B" #1	LOC.	SE NW N
TOTAL DEPTH	3739	COUNTY	Rooks
COMM.	10/10/62 COMP. 10/20/62	STATE	Kansas
RIG NO.	2	ELEVATION	2181 R.L.
CASING:	Set 177' (9jts.) 8-5/8" OD Surface Casing.	PRODUCTION & A	

All measurements taken from the top of rotary bushing.

FROM	TO	FORMATION	DEVIATION FROM VERTICAL	REMARKS:
0	177	Sand-Shale		
177	1070	Shale		
1070	1325	Sand	0°-500	
1325	1340	Shale	0°-1000	
1340	1598	Red Bed		
1598	1635	Anhydrite	0°-1450	
1635	2125	Shale-Shells		
2125	2215	Lime-Shale	0°-2000	
2215	2865	Lime-Shale		
2865	3020	Lime	0°-2590	
3020	3290	Shale-Lime		
3290	3739	Lime		

DST 3580-3620
 DST 3665-3705
 DST 3728-3739

RECEIVED
 NOV 17 1962
 11-19-62
 CONSERVATION DIVISION

STATE OF KANSAS)
 COUNTY OF SEDGWICK) SS.

The undersigned hereby certifies that to the best of his knowledge and belief, the above facts are true and correct.

C-G DRILLING CO.
 By G. F. Galloway

SUBSCRIBED AND SWORN TO, BEFORE ME, THIS 22 day of October, 1962.

Vicky Jacobs
 Vicky Jacobs - Notary Public

My commission expires:
 May 28, 1963

