


STATE OF KANSAS
STATE CORPORATION COMMISSION

Give All Information Completely
Make Required Affidavit
Mail or Deliver Report to:
Conservation Division
State Corporation Commission
800 Biting Building
Wichita, Kansas

WELL PLUGGING RECORD

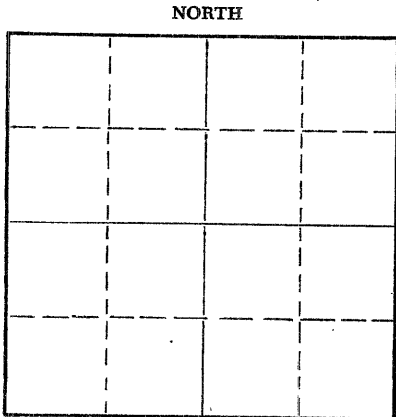

Locate well correctly on above
Section Plat

Rooks County. Sec. 32 Twp. 9 Rge. (E) 19 (W) 19
Location as "NE/CNW/SW" or footage from lines SW SW NW NWWSW
Lease Owner Jones, Shelburne & Farmer, Inc. MR RCC
Lease Name Lund Well No. 4
Office Address Russell, Kansas
Character of Well (completed as Oil, Gas or Dry Hole) Dry
Date well completed 4-19 1955
Application for plugging filed 4-19 1955
Application for plugging approved 4-19 1955
Plugging commenced 4-19 1955
Plugging completed 4-19 1955
Reason for abandonment of well or producing formation Dry

If a producing well is abandoned, date of last production 19
Was permission obtained from the Conservation Division or its agents before plugging was commenced? Yes

Name of Conservation Agent who supervised plugging of this well Eldon Petty
Producing formation _____ Depth to top _____ Bottom _____ Total Depth of Well 3765 Feet
Show depth and thickness of all water, oil and gas formations.

OIL, GAS OR WATER RECORDS

CASING RECORD

FORMATION	CONTENT	FROM	TO	SIZE	PUT IN	PULLED OUT
				8-5/8"	165	None

State of Kansas) Received for record at 8:00 o'clock A. M. on 13 day of June, 1955, and recorded in Book 70 of Register of Deeds
Rooks County) s s Fenneth E. Buss
ORIGINAL Compared with Record

Describe in detail the manner in which the well was plugged, indicating where the mud fluid was placed and the method or methods used in introducing it into the hole. If cement or other plugs were used, state the character of same and depth placed, from _____ feet to _____ feet for each plug set.

1. Filled hole with heavy mud
2. Pushed plug to 156'
3. Dumped 1/2 sacks hulls on top of plug
4. Mixed 15 sacks cement and dumped on top of hulls
5. Filled hole to top
6. Pushed plug to 40'
7. Dumped in 1/2 sack hulls
8. Mixed 10 sacks cement and filled hole to top with RCC

RECEIVED
APR 29 1955
4-29-55

(If additional description is necessary, use BACK of this sheet)
Name of Plugging Contractor Jones, Shelburne & Farmer, Inc.
Address Russell, Kansas

STATE OF Kansas, COUNTY OF Russell, ss. John O. Farmer (employee of owner) or (owner or operator) of the above-described well, being first duly sworn on oath, says: That I have knowledge of the facts, statements, and matters herein contained and the log of the above-described well as filed and that the same are true and correct. So help me God.

(Signature) John O. Farmer
Russell, Kansas (Address)



Subscribed and sworn to before me this 25th day of April, 1955
Lucille Kennedy Notary Public.

PLUGGING
FILE NO. 32-9-19-1955
BOOK PAGE 114 LINE 35

OPERATOR Jones, Shelburne & Farmer, Inc.


FORMATION RECORD

ADDRESS Russell, Kansas

Give detailed description and thickness of all formations drilled through, contents of sand, whether dry, water, oil or gas.

RGE 19
 TWP 9
 SEC 32
 COUNTY Rooks
 WELL NO. 4
 COUNTY Rooks
 FARM NAME Lynd

640 Acres
N

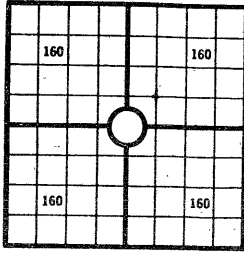

Locate well correctly

COUNTY Rooks, SEC 32, TWP 9, RGE 19
 COMPANY OPERATING Jones, Shelburne & Farmer, Inc.
 OFFICE ADDRESS Russell, Kansas
 FARM NAME Lynd WELL NO. 4
 DRILLING STARTED 4-8-1955 DRILLING FINISHED 4-19-1955
 DATE OF FIRST PRODUCTION _____ COMPLETED _____
 WELL LOCATED SW 1/4 SW 1/4 NW 1/4 North of South
 Line and NW 1/4 NW 1/4 SW 1/4 ft. East of West Line of Quarter Section
 Elevation (Relative to sea level) DERRICK FLOOR 2182 GROUND 2177
 CHARACTER OF WELL (Oil, gas or dryhole) Dry

OIL OR GAS SANDS OR ZONES

Name	From	To	Name	From	To
1			4		
2			5		
3			6		

Perforating Record If Any

Shot Record

Formation	From	To	No. of Shots	Formation	From	To	Size of Shot

CASING RECORD

Amount Set								Amount Pulled		Packer Record	
Size	Wt.	Thds.	Make	Ft.	In.	Ft.	In.	Size	Length	Depth Set	Make
8-5/8				165							

Liner Record: Amount _____ Kind _____ Top _____ Bottom _____

CEMENTING AND MUDDING

Size	Amount Set		Sacks Cement	Chemical		Method of Cementing	Amount	Mudding Method	Results (See Note)
	Ft.	In.		Gal.	Make				
8-5/8	165		100						

Note: What method was used to protect sands if outer strings were pulled? _____

NOTE: Were bottom hole plugs used? _____ If so, state kind, depth set and results obtained _____

TOOLS USED

Rotary Tools were used from _____ feet to _____ feet. Cable tools were used from _____ feet to _____ feet, and from _____ feet to _____ feet, and from _____ feet to _____ feet.

Type Rig _____

INITIAL PRODUCTION TEST

Describe initial test: whether by flow through tubing or casing or by pumping _____

Amount of Oil Production _____ bbls. Size of choke, if any _____ Length of test _____ Water Production _____ bbls. Gravity of oil _____ Type of Pump if pump is used, describe _____

Formation	Top	Bottom	Formation	Top	Bottom
Surface	0	165			
Shale shells & sand	165	680			
Shale sand & shells	680	1100			
Sand	1100	1226			
Shale shells & Red Bed	1226	1380			
Red bed & shell	1380	1609			
Anhydrite	1609	1647			
Shale & shells	1647	1680			
Shale shells & Pyrite	1680	1910			
Shale & shell	1910	2120			
Shale & lime	2120	3430			
Lime & shale	3430	3500			
Lime	3500	3530			
Lime & shale	3530	3595			
Lime	3595	3630			
Shale & lime	3630	3670			
Shale Lime & Chert	3670	3705			
Shale & lime Cong.	3705	3765			
T.D.	3765				

TOPS:

Elevation
 Anhydrite
 Heebner
 Toronto
 Lansing
 Base K.C.

R.B. 2184
 1609
 3388
 3408
 3426
 3635

Arbuckle 3740
 I, the undersigned, being first duly sworn upon oath, state that this well record is true, correct and complete according to the records of this office and to the best of my knowledge and belief.
John W. Farmer, Inc. Pres.
 Name and title of representative of company

Subscribed and sworn to before me this 22nd day of April, 1955
 My Commission expires 10-11-58
Shelburne Farmer
 Notary Public.

2182
 2184
 1556

15-163-00882-00-00