


STATE OF KANSAS  
STATE CORPORATION COMMISSION

WELL PLUGGING RECORD

Give All Information Completely  
Make Required Affidavit  
Mail or Deliver Report to:  
Conservation Division  
State Corporation Commission  
800 Biting Building  
Wichita, Kansas

Rooks County. Sec. 32 Twp. 9 Rge. 19 (W)  
Location as "NE/CNW 1/4 SW 1/4" or footage from lines SE NW  
Lease Owner Sunray Oil Corporation  
Lease Name J. Mead Well No. 1  
Office Address Box 195, Great Bend, Kansas  
Character of Well (completed as Oil, Gas or Dry Hole) Dry Hole  
Date well completed 4/29 19 50  
Application for plugging filed 5/1 19 50  
Application for plugging approved 19  
Plugging commenced 4/29 19 50  
Plugging completed 4/30 19 50  
Reason for abandonment of well or producing formation Dry Hole

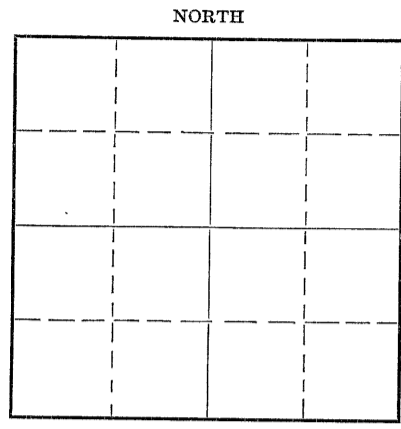

Locate well correctly on above  
Section Plat

If a producing well is abandoned, date of last production 19  
Was permission obtained from the Conservation Division or its agents before plugging was commenced? Yes

Name of Conservation Agent who supervised plugging of this well Eldon Petty  
Producing formation None Depth to top Bottom Total Depth of Well 3778 Feet  
Show depth and thickness of all water, oil and gas formations.

OIL, GAS OR WATER RECORDS

CASING RECORD

Formation	Content	From	To	Size	Put In	Pulled Out
Arbuckle	Water	3759'	3778'	8-5/8"	272'	None

Describe in detail the manner in which the well was plugged, indicating where the mud fluid was placed and the method or methods used in introducing it into the hole. If cement or other plugs were used, state the character of same and depth placed, from feet to feet for each plug set.

Heavy mud from 3778' to 272'. Bridge @ 272'. 25 sax cement 272-200'. Bridge @ 35'.  
Capped w/10 sax cement.

(If additional description is necessary, use BACK of this sheet)

Correspondence regarding this well should be addressed to Sunray Oil Corporation  
Address Box 195, Great Bend, Kansas

STATE OF KANSAS, COUNTY OF BARTON, ss.


Fred McDaniel (employee of owner) of the above-described well,  
being first duly sworn on oath, says: That I have knowledge of the facts, statements, and matters herein contained and the log of the above-described well as filed and that the same are true and correct. So help me God.

(Signature) [Signature] Ass't. Supt.  
Box 195, Great Bend, Kansas (Address)

SUBSCRIBED AND SWORN TO before me this 1st day of May, 1950.

My commission expires April 19, 1952. [Signature] Notary Public.

22-7877-s 4-49-10M

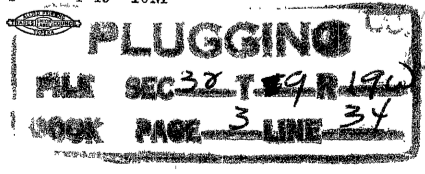

Sunray Oil Corporation  
Philtower Building  
Tulsa, Oklahoma

May 5, 1950

JEMIMA MEAD #1

SE SE NW  
Sec. 32-9S-19W  
Rooks County, Kansas

Contractor: Stickle Drilling Co., Tulsa, Oklahoma

Started: 4-16-50

Finished: 4-30-50

DRILLERS LOG

Cellar	0	5
Sand	5	25
Shale and Sand	25	70
Sand	70	120
Shale	120	272
Shale and Shells	272	700
Sand	700	750
Shale and Shells	750	825
Sand	825	955
Shale	955	1030
Sand	1030	1065
Shale and Shells	1065	1125
Shale	1125	1135
Shale and Shells	1135	1610
Anhydrite	1610	1645
Shale	1645	1985
Shale and Shells	1985	2180
Lime	2180	2660
Shale and Lime	2660	2760
Shale	2760	2845
Lime and Shale	2845	2890
Lime	2890	2980
Shale and Lime	2980	3061
Lime	3061	3220
Lime and Shale	3220	3328
Lime	3328	3648
Lime and Shale	3648	3683
Conglomerate	3683	3759
Arbuckle (Cherty)	3759	3770

8 5/8 set @ 271 w/150 sx  
bulk cement

TD K.B.

Hole plugged w/25 sx @ 271 and 10 sx at Top.

\*\*\*\*\*

STATE OF KANSAS }  
COUNTY OF BARTON } ss.

**PLUGGING**  
FILE SEC 32-9-19W  
BOOK PAGE 3 LINE 34

I, Fred E. Stickle, do hereby certify the above to be a true and complete log of Sunray Oil Corporation's #1 Jemima Mead, located in the SE/4 SE/4 NW/4 Sec. 32-9S-19W, Rooks County, Kansas.

*Fred E. Stickle*

Subscribed and sworn to before me this 5th day of May, 1950.

*Martin Scott*

My commission expires:

My Commission Expires April 19, 1952

5-9-50