

CARD MUST BE TYPED

State of Kansas
NOTICE OF INTENTION TO DRILL
 (see rules on reverse side)

CARD MUST BE SIGNED

Starting Date: 7 29 85
 month day year

OPERATOR: License # 5786
 Name McGown Drilling, Inc.
 Address R#1, Box 28A
 City/State/Zip Mound City, Kansas 66056
 Contact Person Doug McGown
 Phone 913-795-2258

CONTRACTOR: License # 5786
 Name Company Tools
 City/State Mound City, Kansas 66056

Well Drilled For:	Well Class:	Type Equipment:
☒ Oil ☐ Swd	☐ Infield	☒ Mud Rotary
☐ Gas ☐ Inj	☒ Pool Ext.	☐ Air Rotary
☐ OWWO ☐ Expl	☐ Wildcat	☐ Cable

If OWWO: old well info as follows:

Operator
 Well Name
 Comp Date Old Total Depth
 Projected Total Depth 350 feet
 Projected Formation at TD Squirrel
 Expected Producing Formations Squirrel

I certify that we will comply with K.S.A. 55-101, et seq., plus eventually plugging hole to K.C.C. specifications.

Date 7-26-85 Signature of Operator or Agent Marilyn Mitchell Title Agent

API Number 15-

107-22,678-00-00
 Sec 28 .. Twp 19 .. S, Rge 23 ..
 (location) ☒ East ☐ West

4950 Ft North from Southeast Corner of Section
 990 Ft West from Southeast Corner of Section
 (Note: Locate well on Section Plat on reverse side)

Nearest lease or unit boundary line 330 feet.

County Linn

Lease Name Harold Well# I1-85

Domestic well within 330 feet: ☐ yes ☒ noMunicipal well within one mile: ☐ yes ☒ no

Depth to Bottom of fresh water ~50 feet

Lowest usable water formation feet

Depth to Bottom of usable water 150 feet

Surface pipe by Alternate: 1 ☐ 2 ☒

Surface pipe to be set 20 feet

Conductor pipe if any required None feet

Ground surface elevation N/A feet MSL

This Authorization Expires 7-29-86

Approved By 7-29-85 RCH for KCH

Must be filed with the K.C.C. five (5) days prior to commencing well
This card void if drilling not started within six (6) months of date received by K.C.C.


RECEIVED
STATE CORPORATION COMMISSION

APR 29 1988

CONSERVATION DIVISION
Wichita, Kansas

17-29-88

**A Regular Section of Land
1 Mile = 5,280 Ft.**

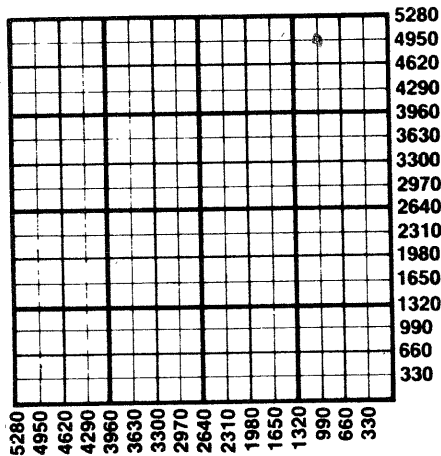

Important procedures to follow:

1. Notify District office before setting surface casing.
2. Set surface casing by circulating cement to the top.
3. File completion forms ACO-1 with K.C.C. within 90 days of well completion, following instructions on ACO-1, side 1, and including copies of wireline logs.
4. Notify District office 48 hours prior to old well workover or re-entry.
5. Prior to plugging, prepare a plugging plan, then obtain agreement from the appropriate district office for an approved plugging plan.
6. Submit plugging report (CP-4) to K.C.C. after plugging is completed.
7. Obtain an approved injection docket number before disposing of salt water.
8. Notify K.C.C. within 10 days when injection commences or terminates.
9. If an alternate 2 completion, cement in the production pipe from below any usable water to surface within 120 days of spud date.

State Corporation Commission of Kansas
Conservation Division
200 Colorado Derby Building
Wichita, Kansas 67202
(316) 263-3238