


STATE OF KANSAS
STATE CORPORATION COMMISSION
Give All Information Completely
Make Required Affidavit
Mail or Deliver Report to:
Conservation Division
State Corporation Commission
800 Bitting Building
Wichita, Kansas

WELL PLUGGING RECORD

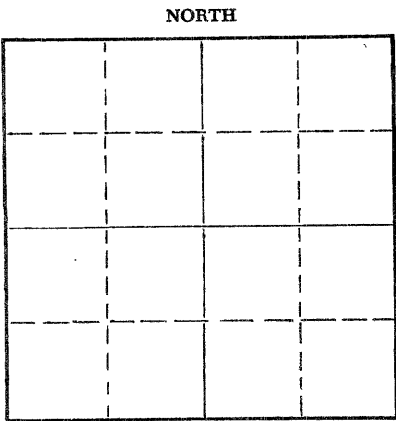

Rooks _____ County. Sec. 30 Twp. 9 Rge. 19 (X) _____ (W) _____
Location as "NE/CNW/SW" or footage from lines NE NE NW
Lease Owner Petroleum, Inc.
Lease Name GICK 'A' Well No. 1
Office Address 311 East Third, Wichita, Kansas
Character of Well (completed as Oil, Gas or Dry Hole) Dry Hole
Date well completed August 2 1955
Application for plugging filed August 2 1955
Application for plugging approved August 2 1955
Plugging commenced August 2 1955
Plugging completed August 2 1955
Reason for abandonment of well or producing formation _____
Dry Hole
If a producing well is abandoned, date of last production _____ 19____
Was permission obtained from the Conservation Division or its agents before plugging was commenced? yes

Name of Conservation Agent who supervised plugging of this well Mr. Eldon Petty, Hays, Kansas
Producing formation _____ Depth to top _____ Bottom _____ Total Depth of Well 3653 Feet
Show depth and thickness of all water, oil and gas formations.

OIL, GAS OR WATER RECORDS					CASING RECORD	
FORMATION	CONTENT	FROM	TO	SIZE	PUT IN	PULLED OUT
				8-5/8"	206'	None

Describe in detail the manner in which the well was plugged, indicating where the mud fluid was placed and the method or methods used in introducing it into the hole. If cement or other plugs were used, state the character of same and depth placed, from _____ feet to _____ feet for each plug set.

Mud up with heavy mud to 200' and set 1st
wooden plug at 200', placed 1/2 sack hulls on top of
plug, placed 15 sacks cement through drill pipe on
top of hulls. Mudded up to 40' and set second wooden
plug, with 1/2 sack hulls on top of plug and 10 sacks
cement to base of well cellar.

(If additional description is necessary, use BACK of this sheet)
Name of Plugging Contractor Garvey Drilling Company
Address R. R. #2 - Great Bend, Kansas

STATE OF KANSAS, COUNTY OF SEDGWICK, ss.
Karl E. Becker (employee of owner) or (owner/operator) of the above-described well, being first duly sworn on oath, says: That I have knowledge of the facts, statements, and matters herein contained and the log of the above-described well as filed and that the same are true and correct. So help me God.

(Signature) Karl E. Becker
311 East Third, Wichita, Kansas (Address)

SUBSCRIBED AND SWORN TO before me this 2nd day of August, 1955

My commission expires July 8, 1958

D. M. Kennedy Notary Public.
RECEIVED
STATE CORPORATION COMMISSION
AUG 18 1955
8-18-55
CONSERVATION DIVISION
Wichita, Kansas

PLUGGING
FILE SEC 30 T 9 R 19W

WELL LOG

15-163-028 25-00-00

COMPANY **Petroleum, Inc.**

SEC. **30** T. **9S** R. **19W**

FARM **CLICK 'A'**

NO. **1**

LOC. **NE NE NW**


TOTAL DEPTH **3653'**

COUNTY **Rock**

COMM. **July 26, 1955**

COMP. **August 2, 1955**

CONTRACTOR **Garvey Drilling Company**

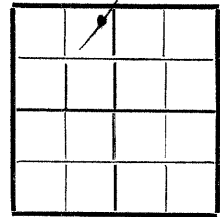

CASING **8-5/8" @ 207 w/135 gals**

ELEVATION **2145' BP**

PRODUCTION **D & A**

FIGURES INDICATE BOTTOM OF FORMATIONS

190	Rock & Clay
206	Shale
1563	Shale & Sand
1895	Anhydrite
2270	Shale & Shells
2680	Lime
2835	Lime & Shale
3355	Lime & Shale
3653	Lime

R.T.D. **3653'**


Geological Tops

Topeka:	3118	(- 967)
Heshner:	3324	(-1173)
Toronto:	3346	(-1195)
Lanning:	3365	(-1214)
Base Kansas City:	3575	(-1424)
Shalay Conglomerate:	3617	(-1466)
Cherty Conglomerate:	3652	(-1501)

State of **KANSAS**

County of **SEDGWICK**

SS:

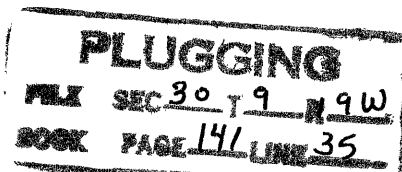

I, **Karl E. Becker**

of

Petroleum, Inc.

upon oath state that the above and foregoing is a true and correct copy of the log of the **CLICK 'A' #1** well

Subscribed and sworn to before me this **19** day of **August**

My Commission Expires: **July 8, 1958**

Karl E. Becker

D. M. Kennedy
NOTARY PUBLIC