


STATE OF KANSAS  
STATE CORPORATION COMMISSION

Form CP-4

WELL PLUGGING RECORD

Give All Information Completely  
Make Required Affidavit  
Mail or Deliver Report to:  
Conservation Division  
State Corporation Commission  
P. O. Box 17027  
Wichita, Kansas 67217  
NORTH

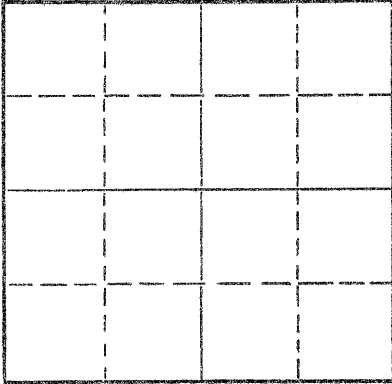

Locate well correctly on above  
Section Flat

Rooks County, Sec. 30 Twp. 9S Rge. (E) 19 (W)  
Location as "NE/CNW/SE/SW" or footage from lines SE NW SW  
Lease Owner Chief Drilling Co., Inc.  
Lease Name Bouchey Well No. 1  
Office Address 905 Century Plaza - Wichita, Kansas  
Character of Well (completed as Oil, Gas or Dry Hole) dry  
Date well completed 6-12 1972  
Application for plugging filed 6-12 19 72  
Application for plugging approved 6-12 19 72  
Plugging commenced PM 4:45 6-12 19 72  
Plugging completed 6:20 Pm 6-12 19 72  
Reason for abandonment of well or producing formation dry

If a producing well is abandoned, date of last production none 19  
Was permission obtained from the Conservation Division or its agents before plugging was commenced? Leo Massey

Name of Conservation Agent who supervised plugging of this well  
Producing formation Depth to top Bottom Total Depth of Well 3765 Feet  
Show depth and thickness of all water, oil and gas formations.

OIL, GAS OR WATER RECORDS

CASING RECORD

FORMATION	CONTENT	FROM	TO	SIZE	PUT IN	PULLED OUT
Surface		0	221	8 5/8	221	0

Describe in detail the manner in which the well was plugged, indicating where the mud fluid was placed and the method or methods used in introducing it into the hole. If cement or other plugs were used, state the character of same and depth placed, from feet to feet for each plug set.

Plugged hole w/ 110 cu ft. cement @ 875' 30 cu ft @ 250'  
10 cu ft @ 40' 2 sx in rat hole By Sun

RECEIVED  
STATE CORPORATION COMMISSION  
JUN 15 1972  
6-15-72  
CONSERVATION DIVISION  
Wichita, Kansas

(If additional description is necessary, use BACK of this sheet)  
Name of Plugging Contractor B & B Drilling, Inc.  
Address 720 Union Center - Wichita, Kansas

STATE OF Kansas, COUNTY OF Sedgwick, ss.  
Bill Lahar (employee of owner) or (owner or operator) of the above-described well, being first duly sworn on oath, says: That I have knowledge of the facts, statements, and matters herein contained and the log of the above-described well as filed and that the same are true and correct. So help me God.

(Signature) Bill Lahar  
720 Union Center - Wichita, Kansas  
(Address)

SUBSCRIBED AND SWORN TO before me this 14th day of June, 19 72

My commission expires May 31, 1974

Alma A. Neises  
Notary Public.

B & B DRILLING, INC.  
720 Union Center  
Wichita, Kansas 67202

June 14, 1972

DRILLERS LOG

Re: Bouchey #1  
SE NW SW Section 30-9S-19W  
Rooks County, Kansas

OPERATOR: Chief Drilling Co., Inc.  
CONTRACTOR: B & B Drilling, Inc.  
COMMENCED: June 6, 1972  
COMPLETED: June 12, 1972  
TOTAL DEPTH: 3765'

Set 8 5/8" @ 221'w/150 sx

0	221	Surface
221	610	Shale & Sand
610	1480	Shale & Sand
1480	1635	Shale
1635	1672	Anhydrite
1672	1910	Shale
1910	2207	Shale & Sand
2207	2662	Shale
2662	3240	Shale & Lime
3240	3490	Lime
3490	3655	Lime
3655	3765	Lime
3765		Total Depth

D & A

DST # 1 3655'

RECEIVED  
STATE CORPORATION COMMISSION  
JUN 15 1972  
CONSERVATION DIVISION  
Wichita, Kansas

We certify the above and foregoing to be true and correct copy of the log on the #1 Bouchey, located in Rooks County, Kansas.

Bill Lohar President

Alma G. Neese Notary Public  
Subscribed and sworn to before me this 14th day of June, 1972, My commission expires May 31, 1974

