


STATE OF KANSAS
STATE CORPORATION COMMISSION

Give All Information Completely
Make Required Affidavit
Mail or Deliver Report to:
Conservation Division
State Corporation Commission
800 Biting Building
Wichita, Kansas

WELL PLUGGING RECORD

Rooks County. Sec. 15 Twp. 9S Rge. 19W (E) (W)

Location as "NE/CNW/SW" or footage from lines SE SE NW
Lease Owner Bankoff Oil Company
Lease Name Casey Well No. 6
Office Address 823 N. Lewis, Tulsa, Oklahoma
Character of Well (completed as Oil, Gas or Dry Hole) Dry Hole
Date well completed 11-14 19 55
Application for plugging filed 11-14 19 55
Application for plugging approved 11-14 19 55
Plugging commenced 11-14 19 55
Plugging completed 11-14 19 55
Reason for abandonment of well or producing formation Dry Hole

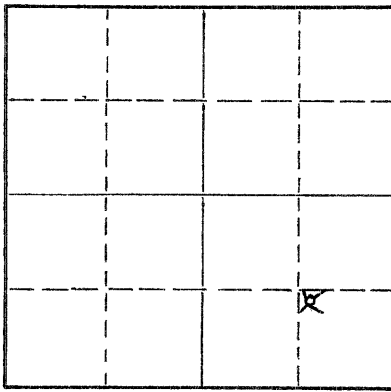

Locate well correctly on above
Section Plat

If a producing well is abandoned, date of last production _____ 19____
Was permission obtained from the Conservation Division or its agents before plugging was commenced? Yes

Name of Conservation Agent who supervised plugging of this well E. R. Petty, Hays, Kansas
Producing formation _____ Depth to top _____ Bottom _____ Total Depth of Well 3557 Feet
Show depth and thickness of all water, oil and gas formations.

OIL, GAS OR WATER RECORDS

CASING RECORD

FORMATION	CONTENT	FROM	TO	SIZE	PUT IN	PULLED OUT
				8 5/8"	197	

Describe in detail the manner in which the well was plugged, indicating where the mud fluid was placed and the method or methods used in introducing it into the hole. If cement or other plugs were used, state the character of same and depth placed, from _____ feet to _____ feet for each plug set.

1st plug 190 ft, 1/2 sk hulls,
15 sks cement, rotary mud to
40 ft, plug w/1/2 sks hulls,
10 sks cement to surface.

RECEIVED
STATE CORPORATION COMMISSION

NOV 22 1955

11-22-55
CONSERVATION DIVISION
Wichita, Kansas

(If additional description is necessary, use BACK of this sheet)
Name of Plugging Contractor Leben Drilling Company
Address 505 Orpheum Bldg, Wichita 2, Kansas

STATE OF KANSAS, COUNTY OF SEDGWICK, ss.
Norma D. Sisson (employee of owner) or (owner or operator)

of the above-described well, being first duly sworn on oath, says: That I have knowledge of the facts, statements, and matters herein contained and the log of the above-described well as filed and that the same are true and correct. So help me God.

(Signature) Norma D. Sisson

Wichita, Kansas

(Address)

SUBSCRIBED AND SWORN TO before me this 21st day of November, 19 55

My commission expires April 20, 1959

Notary Public.

PLUGGING
FILE SEC 15 T9 R29W
BOOK PAGE 17 LINE 21

CONTRACTOR'S WELL LOG

COMPANY: Bankoff Oil Company
 CONTRACTOR: Leben Drilling Company
 FARM: Casey #6,
 LOCATION: SE SE NW Sec. 15-9S-19W,
 Rooks County, Kansas
 COMMENCED: November 4, 1955
 COMPLETED: November 14, 1955

0	197	Surface sand
197	345	Shale, redbed
345	943	Shale
943	1050	Sand
1050	1459	Shale, redbed
1459	1505	Anhydrite
1505	1747	Shale, lime
1747	2052	Lime, shale
2052	2357	Lime
2357	2527	Lime, shale
2527	2777	Shale, lime
2777	2912	Lime, shale
2912	3026	Shale, lime
3026	3248	Lime, shale
3248	3540	Lime
3540	3557	Arbuckle
	<u>3557</u>	<u>Rotary Total Depth, D & A</u>

Set 190.83 feet of 8 5/8" surface casing at 197 feet.

I, Norma D. Sisson, do hereby certify that the above and foregoing is a true and correct copy of the log of the Casey #6, SE SE NW Sec. 15-9S-19W, Rooks County, Kansas, as reflected by the files of the Leben Drilling Company.

LEBEN DRILLING COMPANY

BY:

Norma D. Sisson

STATE OF KANSAS)
 COUNTY OF SEDGWICK)SS

Subscribed and sworn to before me, a Notary Public, in and for Sedgwick County, Kansas, this 21st day of November, 1955

Norma D. Sisson

My commission expires April 20, 1959

RECORDS SECTION
 STATE OF KANSAS

CONSERVATION DIVISION
 Topeka, Kansas

PLUGGING
 FILE SEC 15 T 9 R 19W
 BOOK PAGE 17 LINE 21