


STATE OF KANSAS
STATE CORPORATION COMMISSION

WELL PLUGGING RECORD

Give All Information Completely
Make Required Affidavit
Mail or Deliver Report to:
Conservation Division
State Corporation Commission
800 Bittling Building
Wichita, Kansas

OR
FORMATION PLUGGING RECORD Strike out upper line when reporting plugging off formations.

Rooks County. Sec. 15 Twp. 9.S Rge. 19 ~~EX W~~ (W)
Location as "NE $\frac{1}{4}$ NW $\frac{1}{4}$ SW $\frac{1}{4}$ " or footage from lines. SW SW SE
Lease Owner. Aledo Oil and Gas Company, Inc.
Lease Name. Bartoes Well No. #2
Office Address. 1411 Union National Bank Building
Character of Well (completed as Oil, Gas or Dry Hole). Dry Hole
Date well completed. 6-25-49 19
Application for plugging filed. 6-25-49 19
Application for plugging approved. 6-25-49 19
Plugging commenced. 6-26-49 19
Plugging completed. 6-26-49 19
Reason for abandonment of well or producing formation. D & A
If a producing well is abandoned, date of last production. * * 19
Was permission obtained from the Conservation Division or its agents before plugging was commenced? Yes

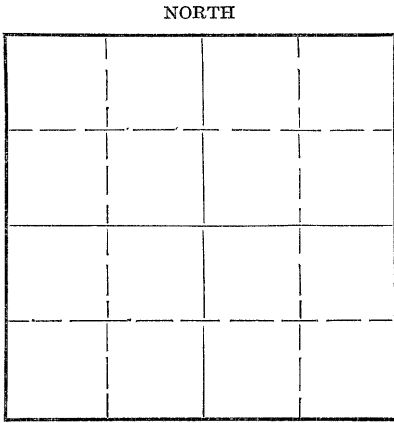

Locate well correctly on above Section Plat

Name of Conservation Agent who supervised plugging of this well. C.D. Stough
Producing formation. Depth to top. Bottom. Total Depth of Well. 3584 Feet
Show depth and thickness of all water, oil and gas formations.

OIL, GAS OR WATER RECORDS

CASING RECORD

Formation	Content	From	To	Size	Put In	Pulled Out
				8 5/8	166'	None

Describe in detail the manner in which the well was plugged, indicating where the mud fluid was placed and the method or methods used in introducing it into the hole. If cement or other plugs were used, state the character of same and depth placed, from _____ feet to _____ feet for each plug set.

Used heavy mud to within 166' of top. 1st plug @ 166' with 15 sacks cement. 2nd plug @ 30' with 10 sacks cement to cellar.

RECEIVED
7-1-49
JUL-1 1949
STATE CORPORATION COMMISSION
KANSAS

(If additional description is necessary, use BACK of this sheet)
Correspondence regarding this well should be addressed to. Aledo Oil and Gas Company, Inc.
Address. 1411 Union National Bank Building, Wichita 2, Kansas

STATE OF Kansas, COUNTY OF Sedgwick, ss.
Glen Burris (employee of owner) of the above-described well, being first duly sworn on oath, says: That I have knowledge of the facts, statements, and matters herein contained and the log of the above-described well as filed and that the same are true and correct. So help me God.
(Signature) Glen Burris
Glen Burris, Sec'y Treas.
1033 North Pershing, Wichita, Kansas (Address)

SUBSCRIBED AND SWORN to before me this 30th day of June, 19 49

My commission expires August 25, 1952

Leta Helm Notary Public.

PLUGGING
FILE SEC 15 T 9 R 194
BOOK PAGE 103 LINE 21

COMPANY: Aledo Oil & Gas Co., Inc.
 CONTRACTOR: Jackson Drilling Corporation
 FARM: Bartos #2
 LOCATION: SW 4 SW 4 SE 4 Section 15-9-19W
 Rooks County, Kansas
 COMMENCED: June 16, 1949
 COMPLETED: June 26, 1949

0	to	69	Surface - sand clay & gravel
69	to	385	Shale
385	to	700	Shale & shells
700	to	870	Shale & sand
870	to	920	Shale
920	to	955	Pyrite & shale
955	to	1150	Sand w/shale
1150	to	1450	Red Bed & shells
1450	to	1480	pyrite & shale
1480	to	1525	Anhydrite
1525	to	1850	Shale & shells
1850	to	1920	Shale & salt
1920	to	2035	Shale & lime
2035	to	2130	Shale & shells
2130	to	2155	Lime
2155	to	2230	Shale & shells
2230	to	2480	Lime & shale
2480	to	2775	Lime & shale
2775	to	2935	Shale & shells
2935	to	3120	Shale & lime
3120	to	3250	Lime
3250	to	3340	Lime & shale
3340	to	3550	Lime
3550	to	3554	Shale
3554	to	3584	Arbuckle
		3584 T.D.	

8 5/8" - 32# casing set at 169 feet - Cemented with 125 sacks cement.

Top Arbuckle

Dry and Abandoned

7-1-49

Measurements taken from top of derrick floor.

C E R T I F I C A T E

I, Clare A. Stewart, do hereby certify that the above and foregoing is a true and correct copy of log of the Bartos #2, Section 15-9-19W, Rooks County, Kansas, as reflected by files of the Jackson Drilling Corporation.

Clare A. Stewart
 Clare A. Stewart

Subscribed and sworn to before me, a Notary Public, within and for Johnson County, Kansas, this 29th day of June, 1949.

Dorothy J. Wilson
 Dorothy J. Wilson

My Commission expires November 30, 1950

PLUGGING
 FILE SEC 15 T 9 R 19W
 BOOK PAGE 103 LINE 21