


15-163-19337-00-00

Give All Information Completely  
Make Required Affidavit  
Mail or Deliver Report to:  
Conservation Division  
State Corporation Commission  
211 No. Broadway  
Wichita, Kansas

WELL PLUGGING RECORD

NORTH

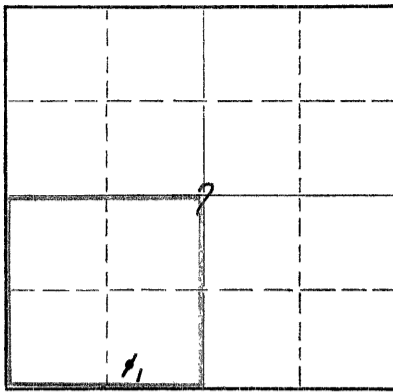

Locate well correctly on above  
Section Plat

Rooks County. Sec. 7 Twp 9S Rge. (E) 20 (W)  
Location as "NE/CNW%SW%" or footage from lines SW/4 SE/4 SW/4  
Lease Owner Skelly Oil Company  
Lease Name Desmarteau "A" Well No. 1  
Office Address Box 1650, Tulsa, Oklahoma  
Character of Well (completed as Oil, Gas or Dry Hole) Dry Hole  
Date well completed November 9, 19 56  
Application for plugging filed November 9, 19 56  
Application for plugging approved November 13, 19 56  
Plugging commenced November 12, 19 56  
Plugging completed November 24, 19 56  
Reason for abandonment of well or producing formation Dry Hole

If a producing well is abandoned, date of last production \_\_\_\_\_ 19\_\_\_\_  
Was permission obtained from the Conservation Division or its agents before plugging was commenced? Yes

Name of Conservation Agent who supervised plugging of this well Mr. Eldon Petty  
Producing formation \_\_\_\_\_ Depth to top \_\_\_\_\_ Bottom \_\_\_\_\_ Total Depth of Well 3825 Feet  
Show depth and thickness of all water, oil and gas formations.

OIL, GAS OR WATER RECORDS

CASING RECORD

FORMATION	CONTENT	FROM	TO	OD SIZE	PUT IN	PULLED OUT
<u>Arbuckle Lime</u>	<u>Dry</u>	<u>3755'</u>	<u>3825'</u>	<u>8-5/8"</u>	<u>272' 0"</u>	<u>None</u>
				<u>5-1/2"</u>	<u>3787' 0"</u>	<u>2725' 9"</u>

Describe in detail the manner in which the well was plugged, indicating where the mud fluid was placed and the method or methods used in introducing it into the hole. If cement or other plugs were used, state the character of same and depth placed, from \_\_\_\_\_ feet to \_\_\_\_\_ feet for each plug set.

Sand 3825' to 3764'  
Cement 3764' to 3756'  
Bridging plug 3740'  
Sand 3740' to 3715'  
4 sacks of cement 3715' to 3683'  
Mud laden fluid 3683' to 270'  
Rock bridge 270' to 260'  
20 sacks of cement 260' to 210'  
Mud laden fluid 210' to 35'  
Rock bridge 35' to 25'  
10 sacks of cement 25' to 6'  
Surface soil 6' to 0'

CONSERVATION DIVISION  
Wichita, Kansas

(If additional description is necessary, use BACK of this sheet)

Name of Plugging Contractor Ace Pipe Pulling Company  
Address P.O. Box 304, Great Bend, Kansas

STATE OF Kansas, COUNTY OF Reno, ss.  
H. E. Wamsley (employee of owner Skelly Oil Company) of the above-described well, being first duly sworn on oath, says: That I have knowledge of the facts, statements, and matters herein contained and the log of the above-described well as filed and that the same are true and correct. So help me God.

(Signature) \_\_\_\_\_  
Box 391, Hutchinson, Kansas  
(Address)

SUBSCRIBED AND SWORN TO before me this 8th day of December, 19 56


My commission expires April 7, 1959

Josephine L. Johnson  
Notary Public.

PLUGGING  
FILE SEC 7 1 9 R20W  
BOOK PAGE 115 L E 16

15-163-19337-00-00

# SKELLY OIL COMPANY

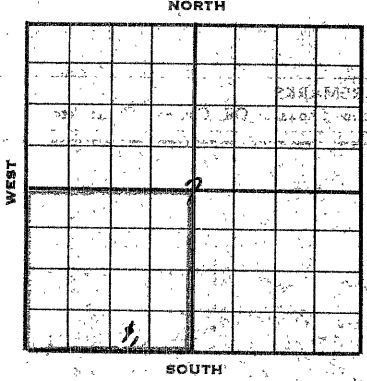

## Well Record

Lease Name and No. Department #17 75237 Well No. 1 Elev. 2212'  
 Lease Description: 1/4 of Section 7-9-201,  
Becke County, Kansas (160 Acres)  
 Location made October 5, 1956 by F. J. Curran  
330 feet from North line 990 feet from East line 10/4  
330 feet from South line 500.7 feet from West line of 500.7

Work com'd 10/6 1956 Rig comp'd 10/8 1956 Drig. com'd 10/8 1956 Drig. comp'd 10/30  
 Rig Contractor: Claude Wentworth Drilling Co., Inc.  
 Drilling Contractor: Claude Wentworth Drilling Co., Inc., Tulsa, Oklahoma  
 Rotary Drilling from 0' to 3762' Cable Tool Drilling from 3762' to 3825'

Commenced Producing DRY HOLE 1956 Initial Prod. before shot or acid  
 Initial Prod. after shot or acid  
 Dry Gas Well Press \_\_\_\_\_ Volume \_\_\_\_\_  
 Casing Head Gas Pressure \_\_\_\_\_ Volume \_\_\_\_\_  
 Braden Head (6-5/8" OD) Gas Pressure \_\_\_\_\_ Volume \_\_\_\_\_  
 Braden Head (        ) Gas Pressure \_\_\_\_\_ Volume \_\_\_\_\_

PRODUCING FORMATION DRY HOLE (Name) Top \_\_\_\_\_ Bottom \_\_\_\_\_ TOTAL DEPTH 3825'

### CASING RECORD

OD Size	Wt.	Thds.	Where Set	PULLED OUT			LEFT IN			KIND	Cond'n	CEMENTING	
				Jts.	Feet	In.	Jts.	Feet	In.			Sacks Used	Method Employed
6-5/8"	22.7	J	378'				7	272	0	Arches 35	A	175	Halliburton
5-1/2"	14.0	R		64	2725	0	7	132	1	140 R2 35	A		
5-1/2"	14.0	R	3737'				26	909	2	355 R2 35	A	175	Halliburton
(6-5/8" casing set 1' in collar and 1/2" cement to serrick floor)													

Liner Set at \_\_\_\_\_ Length \_\_\_\_\_ Perforated at \_\_\_\_\_  
 Liner Set at \_\_\_\_\_ Length \_\_\_\_\_ Perforated at \_\_\_\_\_  
 Packer Set at \_\_\_\_\_ Size and Kind \_\_\_\_\_  
 Packer Set at \_\_\_\_\_ Size and Kind \_\_\_\_\_

### SHOT OR ACID TREATMENT RECORD

	FIRST	SECOND	THIRD	FOURTH
Date	10/26/56	10/31/56	11/6/56	
Acid Used	500		300	
Size Shot		Gals. Qts.	Gals. Qts.	
Shot Between	3755 Ft. and 3764 Ft.	3756 Ft. and 3764 Ft.	3750 Ft. and 3755 Ft.	
Size of Shell				
Put in by (Co.)	Halliburton	Halliburton	Halliburton	for remaining treatments
Length anchor				remarks
Distance below Cas'g		(acid-free)		
Damage to Casing or Casing Shoulder				

### SIGNIFICANT GEOLOGICAL FORMATIONS

NAME	Top	Bottom	GAS		OIL		REMARKS
			From	To	From	To	
Seebner shale	3420'						
Toronto lime	3443'						
Lansing lime	3461'						
Conglomerate	3737'						
Arbuckle lime	3735'						

### CLEANING OUT RECORDS

	DATE COMMENCED	DATE COMPLETED	PROD. BEFORE	PROD. AFTER	REMARKS
1st					See Reverse for other de
2nd					" " " "
3rd					" " " "
4th					" " " "

### PLUGGING BACK AND DEEPENING RECORDS

	Date Commenced	Date Completed	No. Feet Plugged Back or Deepened	Prod. Before	Prod. After	REMARKS
1st						See Reverse for other de
2nd						" " " "
3rd						" " " "
4th						" " " "

(See Reverse for Record of Formation)

# RECORD OF FORMATIONS

FORMATION	TOP	BOTTOM	REMARKS <small>Indicate Casing Points, Describe Shows of Oil, Gas and Water, etc.</small>
Surface soil, clay, and sand rock	0	140	
Shale and rock	140	265	
Shale and shells	265	278	Set and cemented 5-5/8" ID, 12.75' length 3.4%, 3.4% steel casing (A cond.) at 278' with 175 sacks of common cement with 7% calcium chloride. Cement circulated.
Clay and shale	278	3005	
Red, shale and shells	1005	1712	TOP SANDSTONE 1705'
Hydrite	1712	1751	TOP SANDSTONE 1750'
Shale and shells	1751	2315	TOP SANDSTONE 2050'
Coarse, medium grained sand	3748	3754	Fair to poor porosity, show of free oil.
	3754	3755	San Halliburton drill stem test No. 1, packer set at 3736', used 19' anchor, open 60 minutes, weak blow for 5 minutes, recovered 15' rotary mud, few specks sand looking oil, SRF-30 in 20 min., RFP-02, RFP-03.
	3755	3756	TOP SANDSTONE 3755'
Clay and tan, fine to medium crystalline dolomite	3756	3762	Fair to fair porosity, fair to good saturation, free oil in samples.
			Set and cemented 2477' 10" of 5 1/2" OD, 1 1/2" BS thd., N-2, N-40, S.S. casing (A cond.); and 909' 2" of 5 1/2" OD, 1 1/2" N-2, J-53, S.S. casing (A cond.) at 3757' with 175 sacks of special oil well cement. Finished cementing at 10:00 p.m. Opened stage collar at 3723' with 1000-02. Circulated 1 hour, show of cement. Spotted 139 barrels of heavy oil behind 5 1/2" casing, oil circulated. Closed stage collar with 1400-02. Fin. 2:00 a.m. 10/20/36.
			Rigged up cable tools and grabbed and bailed the hole down to top of stage collar on October 22, 5 1/2" casing tested dry. Drilled out stage collar and bailed the hole dry to 3723'. Drilled cement plug to 3757' and cleaned it to bottom, 3762', no shows. Drilled deeper:
Clay, medium crystalline dolomite with some white chert	3762	3763	Spotted porosity and saturation, light show of free oil, no fill up.
	3763	3765	No increase in fluid
Dark shale	3765	3769	San Lane Wells Hanna Key Neutron survey from 3769' to 0'.
			Bailed and tested 6 hours, 17 gallons of oil and no water. Flugged hole with sand from 3769' to 3764' with 16 1/2 gallons of sand to shut off hole. Ran 2" tubing and filled hole with 9 1/2 barrels of oil. Tried to treat with 500 gallons of 1 1/2% Halliburton acid, unable to treat at 1800 psi maximum CP for 14 hours. Reversed out acid. Spotted 350 gallons of Halliburton HCA acid on bottom and held 1800-CP for 7 1/2 hours, unable to treat. Reversed out HCA acid and pulled 2" tubing. Swabbed out 94 barrels oil used to load hole and pumped to bottom.
			Bailed and cleaned out sand from 3764' to 3769' and ran 700' of oil hole. Perforated 5 1/2" casing and open hole from 3756' to 3764' with 32 San-Lane shots, no change in fluid. Flugged back with 10 gallons sand from 3769' to 3764'. Ran 2" tubing and set Halliburton BH packer 3750'. Filled annulus with 91 barrels of oil and pressured annulus 1000 psi. Treated with 500 gallons of Halliburton HCA acid as follows:

ACID TREATMENT NO. 1 - Between 3756' and 3764'

Treatment put in 10/15/36 by Halliburton, using 500 gallons of acid and 15 barrels of oil to flush.

TIME	SP	TP	REMARKS
7:10 pm			Start to load hole
8:00 pm			Hole loaded
8:10 pm			Start to spot acid
8:15 pm	300	0	acid on bottom
8:50 pm	1200	1500	
9:30 pm	1400	1800	
11:15 pm	1800	1800	250 gallons of acid in formation
11:40 pm	1500	1400	310 gallons of acid in formation
11:55 pm	1500	1300	500 gallons of acid in formation

Swabbed through 2" tubing 1 hour, 15 barrels of oil used in creating. Swabbed through 2" tubing 4 hours, 1 barrel of acid water and swabbed hole dry. On October 27, pulled 2" tubing and swabbed and bailed the hole dry and cleaned out sand from 3764' to 3769', 2 gallons of oil per hour. Drilled deeper:

Hard, gray cherty conglomerate with vari-colored pyritic shale

Same	3769	3775	No increase in fluid
Same	3775	3777	
Same	3777	3780	
Same	3780	3785	

White to medium crystalline dolomite

Same	3785	3787	No increase in fluid
------	------	------	----------------------

Soft, cherty conglomerate with various colored shale and traces of sand

Same	3787	3810	No increase in fluid
	3810	3815	Tested 2 hours, 2 barrels of water with slight show of oil per hour

TOTAL DEPTH 3825'

Plugged back with sand from 3825' to 3764'. Ran 2" tubing and set Halliburton BH packer at 3730', used 83 barrels of oil to fill annulus. Pressured casing to 800', input below packer 3 barrels per minute at 3000', used 20 barrels of oil for input test. Ran Halliburton acid-free as follows:

ACID-FREE TREATMENT NO. 1 - Between 3756' and 3764'

Used 2000 gallons of hot acid 1000' of sand

Maximum TP-3000', minimum TP-1800', final TP-1300'

Shut in 8 hours and pressure dropped to 800'. Released pressure and pulled 2" tubing and packer. Swabbed through 3/4" casing 2 hours, 133 barrels of oil used in treating with show of water. Swabbed to bottom, then bailed and tested 6 hours, 25 gallons of water per hour with slight show of oil.

Ran 2" tubing and set Halliburton BH retainer at 3730' and cemented off Arbuckle Line with 75 sacks of special oil well cement. Estimated 70 sacks below retainer at 3000' TP. Recovered out 5 sacks of cement and pulled 2" tubing.

On November 3, swabbed and bailed the hole dry to top of retainer at 3730' and 3/4" casing tested dry. Drilled out BH retainer and drilled cement plug to 3756' and hole tested dry.

Perforated 3/4" casing from 3750' to 3755' with 65 holes by Lane-Wells, no shows. Ran 2" tubing and set Halliburton BH packer at 3730'. Filled annulus with 88 barrels of water, then treated with 300 gallons of Halliburton HCl acid as follows:

ACID TREATMENT NO. 1 - Between 3749' and 3755'

Treatment put in 11/6/36 by Halliburton, using 300 gallons of acid and 14 barrels of oil to flush.

TIME	SP	TP	REMARKS
11:11 am			Start acid
11:20 am			acid on formation
12:00 pm	500		Casing loaded
12:25 pm	500	2000	20 gallons of acid in
12:45 pm	800	2400	100 gallons of acid in
1:00 pm	600	1800	300 gallons of acid in

Pulled 2" tubing and packer and swabbed through 3/4" casing 2 hours, 14 barrels of oil used in treating and 88 barrels of water. Bailed and tested 1 hour, hole dry. Ran 2" tubing, filled hole with 88 barrels of oil, then set BH packer at 3730'. Input test below packer 4 barrels per minute at 4000' TP. Ran Halliburton Sand-Oil-Free treatment as follows:

ACID TREATMENT No. 1 - Between 1740' and 1755'

Used 7000 gallons of oil  
 1000 of sand  
 Maximum TP-4600, final TP-1300  
 Flushed with 20 barrels of oil  
 At 4 hours for pressure drop, pressure dropped to 900

Bled off pressure and pulled 2" tubing and packer. Washed through 5/8" casing 2 hours, 160 barrels of oil used in treating. Bailed and tested 1 hour, hole dry.

Set Baker bridging plug at 1740' and perforated 5/8" casing from 1732' to 1735' with 18 holes by Lane-wells, and from 1725' to 1730' with 30 holes by Lane-wells, no shows. Treated through 5/8" casing with 500 gallons of acid as follows:

ACID TREATMENT No. 2 - Between 1725'-30' and 1732'-35'

Treatment put in 11/9/56 by Halliburton, using 500 gallons of acid and 50 barrels of oil.

TIME	TEMP	TIME
8:20 pm		Start acid
8:35 pm		Start flush
8:45 pm		Acid on formation
9:10 pm	1250'	25 gallons of acid in formation
10:00 pm	1250'	100 gallons of acid in formation
10:30 pm	1250'	500 gallons of acid in formation

Washed through 5/8" casing 2 hours, 89 barrels of oil used in treating. Bailed and tested 4 hours, 15 gallons of water per hour with 1000 of oil.

As commercial quantities of oil or gas were encountered in drilling to the total depth of 3875', regular authority was granted to plug and abandon the well.

November 12, machine was moved in and the well plugged as follows:

Washed off and pulled 8 1/2 jts. (2725' 9") of 5/8" 100, 14", 31 lbs. casing (8 cond.)

Sand	3740'	to	3715'
4 sacks of cement	3715'	to	3685'
Mud laden fluid	3685'	to	370'
Rock bridge	370'	to	260'
20 sacks of cement	260'	to	210'
Mud laden fluid	210'	to	35'
Rock bridge	35'	to	25'
10 sacks of cement	25'	to	6'
Surface soil	6'	to	0'

Plugged and abandoned November 21, 1956.

LOGS TEST DATA: Tests were taken at 500', 1000', 1500', 2000', 2500', and 3000' with no deviation from vertical noted.

PLUGGING  
 11/19/56  
 45 LINE 16