


STATE OF KANSAS
STATE CORPORATION COMMISSION

Give All Information Completely
Make Required Affidavit
Mail or Deliver Report to:
Conservation Division
State Corporation Commission
211 No. Broadway
Wichita, Kansas

WELL PLUGGING RECORD

NORTH

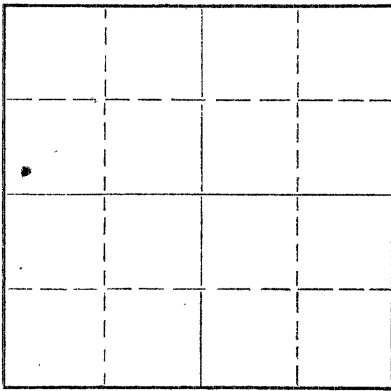

Locate well correctly on above
Section Plat

Rooks County, Sec. 1 Twp. 9 Rge. 19 (X) W (W)
Location as "NE/CNW/SW" or footage from lines SW SW NW
Lease Owner Richardson - Sierra Petroleum Co., Inc.
Lease Name RICHARDSON Well No. 1
Office Address 208 Petroleum Bldg., Wichita Kansas
Character of Well (completed as Oil, Gas or Dry Hole) dry
Date well completed 5/11/54 19
Application for plugging filed 9/5/58 19
Application for plugging approved 9/5/58 19
Plugging commenced 9/17/58 19
Plugging completed 9/21/58 19
Reason for abandonment of well or producing formation dry

If a producing well is abandoned, date of last production 9/5/58 19
Was permission obtained from the Conservation Division or its agents before plugging was commenced? yes

Name of Conservation Agent who supervised plugging of this well Eldon Petty
Producing formation _____ Depth to top _____ Bottom _____ Total Depth of Well 3766 Feet
Show depth and thickness of all water, oil and gas formations.

OIL, GAS OR WATER RECORDS

CASING RECORD

FORMATION	CONTENT	FROM	TO	SIZE	PUT IN	PULLED OUT
				8 5/8	148	none
				5 1/2	3762	996'

Describe in detail the manner in which the well was plugged, indicating where the mud fluid was placed and the method or methods used in introducing it into the hole. If cement or other plugs were used, state the character of same and depth placed, from _____ feet to _____ feet for each plug set.

PLUGGING RECORD

Sanded hole back from 3766 to 3750, dumped 4 sacks cement.
Circulate mud. Spot cement plugs at 570' and 150' mud hole to 40'
set rock bridge cement with 10 sacks cement to base of cellar.

(If additional description is necessary, use BACK of this sheet)

Name of Plugging Contractor Southwest Casing Pulling Co., Inc.
Address Box 364, Great Bend, Kansas

STATE OF KANSAS, COUNTY OF RUSSELL, ss.
S. P. Hall (employee of owner) or (owner or operator) of the above-described

well, being first duly sworn on oath, says: That I have knowledge of the facts, statements, and matters herein contained and the log of the above-described well as filed and that the same are true and correct. So help me God.

(Signature) S. P. Hall

SUBSCRIBED AND SWORN TO before me this 7th day of October, 19 58 (Address)

Margie Cooper Notary Public.

My commission expires 1-30-61.

PLUGGING
FILE SEC. 33 T. 9 R. 19 W.
BOOK PAGE 128 LINE 20

OCT 9 1958
10-9-58
CONSERVATION DIVISION
Wichita, Kansas

COPY

COPY

DRILLER'S LOG

#1 Richardson
SW SW NW Sec. 33-9-19W
Rooks County, Kansas

OWNER: Mallonee Drilling Company, Inc. et all
CONTRACTOR: Mallonee Drilling Company, Inc.

COMMENCED: 4/29/54
COMPLETED: 5/11/54

Elevation: 2224 K.B.

<u>FROM TO</u>	<u>Description</u>	<u>Remarks</u>
0 88	Sand & clay	
88 148	Shale	151' 8 5/8 casing set at 148' with 80 sacks cement and 1 sack c.c.
148 700	Shale	
700 900	Red bed and sand	
900 1000	Sand	
1000 1455	Sand and shale	
1455 1480	Anhydrite	
1480 1630	Shale red rock	
1630 1845	Shale	
1845 1950	Salt	
1950 2240	Shale and shells	
2240 2260	Lime	
2260 2445	Lime and shale	
2445 2710	Shale and shells	
2710 2820	Shale and lime	
2820 3065	Shale and shells	
3065 3108	Lime and shale	
3108 3135	Lime	
3135 3220	Lime and shale	
3220 3655	Lime	
3655 3685	Conglomerate	
3685 3699	Chert and sand	
3699 3729	Conglomerate and chert	DST #1 open 1 hr 280' oil 30' MCO, 1040 #BER
3729 3766	Lime	
3766	Total Depth of hole	3765.04' (123 jts) 5 1/2" casing set at 3762 with 70 sks.

Tops:

Anhydrite	1455 / 769	(B.K.C.)	3655 -1431
Heebner	3407 -1183	Conglomerate	3685 -1446
Toronto	3430 -1206	Arbuckle	3761 -1537
Lansing	3450 -1226	Rotary Total Depth	3766 -1542

I certify that to the best of my knowledge and belief the above represents a true and accurate Drillers Log record of the captioned well.

State of Kansas, County of Sedgwick SS:

Subscribed and sworn to before me this 13th day of May, 1954.

My commission expires:

RECEIVED
CORPORATION COMMISSION
9-9-58
SEP 9 1958

PLUGGING

FILE SEC. 33 T. 9 R. 19W
BOOK PAGE 120 LINE 20