


STATE OF KANSAS
STATE CORPORATION COMMISSION

Give All Information Completely
Make Required Affidavit
Mail or Deliver Report to:
Conservation Division
State Corporation Commission
800 Bittling Building
Wichita, Kansas

WELL PLUGGING RECORD

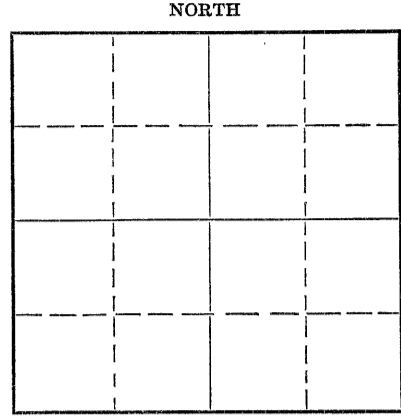

Locate well correctly on above
Section Plat

Rooks County, Sec. **33** Twp. **9S** Rge. **(E) 19 (W)**
Location as "NE/CNW $\frac{1}{4}$ SW $\frac{1}{4}$ " or footage from lines **SW SW NE**
Lease Owner **JONES, SHELburnE & FARMER, INC.**
Lease Name **Richardson** Well No. **1**
Office Address **Russell**
Character of Well (completed as Oil, Gas or Dry Hole) **Dry hole**
Date well completed **9-10** 19**51**
Application for plugging filed **9-10** 19**51**
Application for plugging approved **9-10** 19**51**
Plugging commenced **9-10** 19**51**
Plugging completed **9-10** 19**51**
Reason for abandonment of well or producing formation **Dry**

If a producing well is abandoned, date of last production **Never produced** 19____
Was permission obtained from the Conservation Division or its agents before plugging was commenced? **Yes**

Name of Conservation Agent who supervised plugging of this well **Eldon Petty**
Producing formation _____ Depth to top _____ Bottom _____ Total Depth of Well _____ Feet
Show depth and thickness of all water, oil and gas formations.

OIL, GAS OR WATER RECORDS

CASING RECORD

Formation	Content	From	To	Size	Put In	Pulled Out
				8 5/8	160	none

Describe in detail the manner in which the well was plugged, indicating where the mud fluid was placed and the method or methods used in introducing it into the hole. If cement or other plugs were used, state the character of same and depth placed, from _____ feet to _____ feet for each plug set.

- Hole filled with heavy mud
- Halliburton plug pushed to 160'
- 1/2 sack hulls dumped on top of plug
- 15 sacks cement mixed and spotted on top of hulls
- Second Halliburton plug pushed to 40'
- 1/2 sack hulls dumped on top of plug
- 10 sacks cement mixed and hole filled to top with same.

SEP 12 1951
CONSERVATION DIVISION
Wichita, Kansas

(If additional description is necessary, use BACK of this sheet)

Name of Plugging Contractor **JONES, SHELburnE & FARMER, INC.**
Address **Russell, Kansas**

STATE OF **KANSAS**, COUNTY OF **RUSSELL**, ss.
John O. Farmer (employee of owner) or (owner or operator) of the above-described well,
being first duly sworn on oath, says: That I have knowledge of the facts, statements, and matters herein contained and the log of the above-described well as filed and that the same are true and correct. So help me God.

(Signature) *John O. Farmer*
Russell, Kansas
(Address)

SUBSCRIBED AND SWORN to before me this **11th** day of **September**, 19**51**

My commission expires **February 19, 1955**

Josephine E. Waag
Notary Public

23-8390-651-20M
33 9 1951
109

