


R

Give All Information Completely  
Make Required Affidavit  
Mail or Deliver Report to:  
Conservation Division  
State Corporation Commission  
212 North Market, Insurance Bldg.  
Wichita, Kansas

WELL PLUGGING RECORD

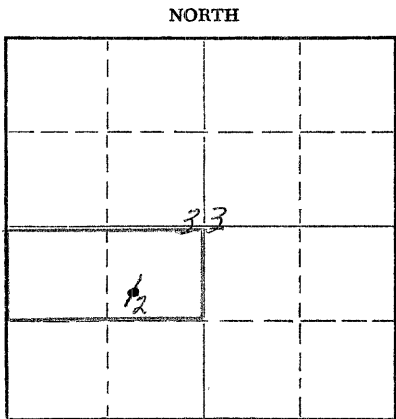

Locate well correctly on above Section Plat

Rooks \_\_\_\_\_ County. Sec. 33 Twp. 9S Rge. \_\_\_\_\_ (E) 19 (W) 14  
Location as "NE/CNW/SW" or footage from lines SW/4 NE/4 SW/4  
Lease Owner Skelly Oil Company  
Lease Name M. L. Casey Well No. 2  
Office Address Box 1650, Tulsa, Oklahoma  
Character of Well (completed as Oil, Gas or Dry Hole) Oil  
Date well completed November 26, 1954  
Application for plugging filed February 13, 1962  
Application for plugging approved ? 19\_\_\_\_  
Plugging commenced February 8, 1962  
Plugging completed February 10, 1962  
Reason for abandonment of well or producing formation Depleted

If a producing well is abandoned, date of last production October 17, 1961  
Was permission obtained from the Conservation Division or its agents before plugging was commenced? Yes

Name of Conservation Agent who supervised plugging of this well Mr. Eldon Petty  
Producing formation Arbuckle Lime Depth to top 3730' Bottom \_\_\_\_\_ Total Depth of Well 3741 Feet  
Show depth and thickness of all water, oil and gas formations.

OIL, GAS OR WATER RECORDS

CASING RECORD

FORMATION	CONTENT	FROM	TO	SIZE	PUT IN	PULLED OUT
Arbuckle Lime	Oil	3731'	3741'	8-5/8"	316'0"	None
				5-1/2"	3760'6"	2834'

Describe in detail the manner in which the well was plugged, indicating where the mud fluid was placed and the method or methods used in introducing it into the hole. If cement or other plugs were used, state the character of same and depth placed, from \_\_\_\_\_ feet to \_\_\_\_\_ feet for each plug set.

Sand		3701'	to	3180'
5 sacks of cement		3180'	to	3140'
Mud		3140'	to	550'
20 sacks common cement		550'	to	490'
10 sacks Halco Gel		490'	to	180'
20 sacks common cement		180'	to	120'
Mud		120'	to	40'
Rock		40'	to	30'
10 sacks common cement		30'	to	6'
Surface soil		6'	to	Surf.

RECEIVED  
STATE CORPORATION COMMISSION  
MAR 19 1962  
3-19-62  
CONSERVATION DIVISION  
Wichita, Kansas

(If additional description is necessary, use BACK of this sheet)  
Name of Plugging Contractor Ace Pipe Service  
Address P.O. Box 304, Great Bend, Kansas


STATE OF Kansas, COUNTY OF Reno, ss.  
D. E. Smith (employee of owner) of Kansas of the above-described well, being first duly sworn on oath, says: That I have knowledge of the facts, statements, and matters herein contained and the log of the above-described well as filed and that the same are true and correct. So help me God.

(Signature) D. E. Smith  
Box 391, Hutchinson, Kansas  
(Address)

SUBSCRIBED AND SWORN TO before me this 16th day of March, 19 62  
My commission expires April 7, 1963  
Josephine L. Johnson Notary Public.



# SKELLY OIL COMPANY

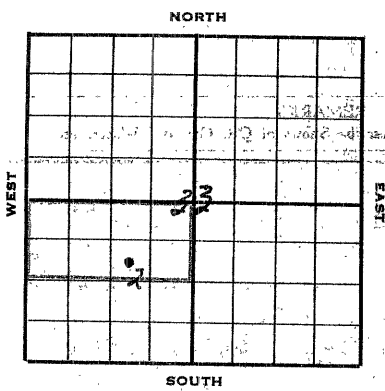

## Well Record

Lease Name and No. H. L. Coney #34810 Well No. 2 Elev. 2195'  
 Lease Description W/2 SW/4 Section 33-9S-19W, Rocks County, Kansas (80 Acres)  
 Location made October 25, 19 54 by P. J. Cussen  
990 feet from North line 990 feet from East line SW/4  
 feet from South line feet from West line of Sec. 33

Work com'd 10/29 19 54 Rig comp'd 10/31 19 54 Drlg. com'd 10/31 19 54 Drlg. comp'd 11/23 19 54  
 Rig Contractor Claude Westworth Drilling Co., Inc.  
 Drilling Contractor Claude Westworth Drilling Co., Inc., Tulsa, Oklahoma  
 Rotary Drilling from 0' to 3732' Cable Tool Drilling from 3732' to 3741'  
 Commenced Producing November 26, 19 54 { Initial Prod. before shot or acid 60 gals. oil/hr.  
 Initial Prod. after shot or acid POB 6 hrs to estab. 24 hr. physical test potential 345 bbls.  
 Dry Gas Well Press \_\_\_\_\_ Volume \_\_\_\_\_  
 Casing Head Gas Pressure \_\_\_\_\_ Volume \_\_\_\_\_  
 Braden Head (2-5/8" 251" OD) Gas Pressure \_\_\_\_\_ Volume \_\_\_\_\_  
 Braden Head ( \_\_\_\_\_ ) Gas Pressure \_\_\_\_\_ Volume \_\_\_\_\_

PRODUCING FORMATION Arbuckle Lime Top 3731' Bottom 3741' TOTAL DEPTH 3741'  
 (Name)

### CASING RECORD

Size	Wt.	Thds.	Where Set	PULLED OUT			LEFT IN			KIND	Cond'n	CEMENTING	
				Jts.	Feet	In.	Jts.	Feet	In.			Sacks Used	Method Employed
<u>8-5/8" 24#</u>			<u>PE 323'</u>				<u>8</u>	<u>316</u>	<u>0</u>	<u>RJ 85</u>	<u>B</u>	<u>175</u>	<u>Halliburton</u>
<u>5-7/8" 15#</u>			<u>RR 3731'</u>				<u>118</u>	<u>3760</u>	<u>6</u>	<u>J35 RZ 85</u>	<u>A</u>	<u>150</u>	<u>Halliburton</u>
<u>(8-5/8" casing set 1' in cellar and 5 1/2' cased to derrick floor)</u>													

**RECEIVED**  
 STATE CORPORATION COMMISSION  
 MAR 19 1962  
 CONSERVATION DIVISION

Liner Set at \_\_\_\_\_ Length \_\_\_\_\_ Perforated at \_\_\_\_\_  
 Liner Set at \_\_\_\_\_ Length \_\_\_\_\_ Perforated at \_\_\_\_\_  
 Packer Set at \_\_\_\_\_ Size and Kind \_\_\_\_\_  
 Packer Set at \_\_\_\_\_ Size and Kind \_\_\_\_\_

### SHOT OR ACID TREATMENT RECORD

	FIRST	SECOND	THIRD	FOURTH
Date	<u>11/23/54</u>			
Acid Used	<u>300 gals. QXXX</u>			
Size Shot				
Shot Between	<u>3731 Ft. and 3741 Ft.</u>	<u>Ft. and Ft.</u>	<u>Ft. and Ft.</u>	<u>Ft. and Ft.</u>
Size of Shell				
Put in by (Co.)	<u>Halliburton</u>			
Length anchor				
Distance below Cas'g				
Damage to Casing or Casing Shoulder				

### SIGNIFICANT GEOLOGICAL FORMATIONS

NAME	Top	Bottom	GAS		OIL		REMARKS
			From	To	From	To	
<u>TOP TOPIKA</u>	<u>3166'</u>						
<u>Heabner shale</u>	<u>3374'</u>						
<u>Toronto</u>	<u>3392'</u>						
<u>Lansing Lime</u>	<u>3413'</u>						
<u>Conglomerate</u>	<u>3627'</u>			<u>3658'</u>	<u>3673'</u>		
<u>Simpson</u>	<u>3698'</u>						
<u>Arbuckle Lime</u>	<u>3730'</u>			<u>3730'</u>	<u>3741'</u>	<u>Bailed 60 gals. oil/hr.</u>	

### CLEANING OUT RECORDS

	DATE COMMENCED	DATE COMPLETED	PROD. BEFORE	PROD. AFTER	REMARKS
1st					<u>See Reverse for other detail</u>
2nd					<u>" " " " "</u>
3rd					<u>" " " " "</u>
4th					<u>" " " " "</u>

### PLUGGING BACK AND DEEPENING RECORDS

	Date Commenced	Date Completed	No. Feet Plugged Back or Deepened	Prod. Before	Prod. After	REMARKS
1st						<u>See Reverse for other detail</u>
2nd						<u>" " " " "</u>
3rd						<u>" " " " "</u>
4th						<u>" " " " "</u>

(See Reverse for Record of Formation)

00-50-11500-201-21

## RECORD OF FORMATIONS

FORMATION	TOP	BOTTOM	REMARKS Indicate Casing Points; Describe Shows of Oil, Gas and Water, etc.
Sand, rock and shale	0	125	
Shale and shells	125	324	Set and cemented 8-5/8" OD, 24' P.S., R-3, S.S. casing (B. cond.) at 323' with 175 sacks of common cement, 3% Cel, and 2% calcium chloride. Cement circulated.
Rammed 9" hole to 12-1/4"			
Shale and shells	324	935	
Sand, shale and shells	935	1350	
Shale, shells and red bed	1350	1600	<u>TOP ANHYDRITE 1593'</u>
Anhydrite	1600	1645	<u>BASE ANHYDRITE 1630'</u>
Shale, shells and red bed	1645	1850	
Shale and salt	1850	1945	
Shale and shells	1945	2072	
Shale and lime	2072	3080	
Shale	3080	3175	<u>TOP TOPEKA 3166'</u>
Shale and lime	3175	3492	<u>TOP HEBBURN SHALE 3176'</u> <u>TOP TORONTO 3192'</u> <u>TOP LANSING LIME 3413'</u>
Cream, dense lime	3492	3498	Spotted stain, trace of oil, fair porosity
Lime and shale	3498	3500	
tan, dense lime	3500	3506	Slight stain, fair vugular porosity
Lime	3506	3509	
tan, dense lime	3509	3512	Poor stain and porosity
Lime	3512	3513	Run Halliburton drill stem test, packer set at 3491', used 22' anchor, open 1 hour, strong blow, recovered 2400' salt water, no oil, BHP-1200', initial flow, 100', final flow 1170'.
Lime and shale	3513	3549	
White, dense lime	3549	3553	Very poor porosity, trace of spotted stain.
Lime and shale	3553	3562	
White, dense lime	3562	3565	
Lime	3565	3584	
White, chalky lime	3584	3591	Poor porosity, poor spotted stain
Lime	3591	3611	
White, chalky lime	3611	3615	Poor porosity, poor spotted stain
Lime	3615	3622	
White, chalky lime	3622	3626	Poor porosity, poor spotted stain
Shale and lime	3626	3655	<u>TOP CAROLINATE 3647'</u>
Vari-colored chert	3655	3686	Oil stained, some porosity, oil saturation, heavy dark free oil, free oil and odor in samples
Shale and lime	3686	3706	<u>TOP SIMPSON 3698'</u>
Lime to medium grained sand	3706	3710	Dark dead oil staining, fair porosity
Lime	3710	3730	<u>TOP ARBOULE LIME 3730'</u>
Lime to medium crystalline dolomite, poor porosity	3730	3732	Spotted stain with trace of saturation and free oil
Set and cemented 5 1/2" OD, 15.5' OD ann., R-2, J-55, JAL S.S. casing (B. cond.) at 3731' with 150 sacks of cement and 1% Cel. Finished 6:00 p.m. 11/12/54. Opened stage collar at 3755' with 900'-CP, circulated 1 hour, spotted 155 barrels of heavy oil behind 5 1/2" casing, oil circulated, closed stage collar with 1400'-CP. Finished 11/12/54 at 8:00 p.m.			
Moved in cable tools on November 17, swabbed and bailed hole dry to 3765', 5 1/2" casing tested dry. Drilled cement plug and cleaned out to bottom, 3732', no steel lips correction, cement tested OK. Deepened as follows:			
Gray, medium crystalline dolomite, slight porosity and stain	3732	3733	Show of water and oil, no fill
Run Lane-wells Gamma Ray Neutron Survey. Found leak in stage collar at 3156'. Set Baker bridging plug at 3168'. Filled hole with water, unable to pump into stage collar at 1000' pressure. Perforated 5 1/2" casing from 3152' to 3153' with 4 holes, and from 3160' to 3161' with 4 holes by Lane-wells. Ran 2" tubing with Halliburton DM retainer set at 3130'. Cemented with 60 sacks of common cement and 2% calcium chloride followed with 65 sacks of common cement. Estimated 105 sacks of cement below retainer, reversed out estimated 30 sacks of cement. Pulled 2" tubing and shut down for cement to set.			

On November 22, swabbed and bailed hole dry to top of DM retainer at 3130', 5 1/2" casing tested dry. Drilled out retainer at 3130' and cement to 3168', 5 1/2" casing tested dry. Drove bridging plug from 3168' to bottom and drilled up bridging plug at 3733'.

Gray and brown, finely crystalline dolomite	3733	3735	Poor porosity and saturation no oil
Same	3735	3737	No shows
Gray and brown medium crystalline dolomite with trace of green shale	3737	3739	Poor porosity, slight saturation, slight show of oil
Gray and brown medium crystalline dolomite, slight increase in green shale	3739	3741	Good porosity and saturation Bailed and tested 60 gallons of oil per hour, no water

TOTAL DEPTH 3741'

Treated through 5 1/2" casing with 300 gallons of Halliburton 15% acid as follows:

ACID TREATMENT NO. 1 - Between 3731' and 3741' Treatment put in 11/23/54 by Halliburton, using 300 gallons of acid and 98 barrels of oil to fill and flush hole.

TIME	OP.	IP	REMARKS
10:22 pm			Start acid in
10:24 pm			300 gallons of acid in, start oil
10:44 pm			acid on bottom
11:00 pm	Vac.		30 gallons of acid in formation
11:15 pm	Vac.		100 gallons of acid in formation
11:25 pm	Vac.		220 gallons of acid in formation
11:37 pm	Vac.		300 gallons of acid in formation Flushed with 8 barrels of oil

Swabbed through 5 1/2" casing 3 hours, 87 barrels of oil used in treating, then swabbed 3 hours, 42 barrels of oil with trace of acid water. Ran 2" tubing and rods and on November 24, FOB 6 hours, 72 barrel of oil and 25 barrels of water.

On November 26, FOB 8 hours on physical potential, 115.37 barrels of oil and 11 barrels of water to establish 24 hour State Corporation Commission potential of 346 barrels. allowable 25 barrels per day.

SLOPE TEST DATA

DEPTH	ANGLE OF DEFLECTION
250'	3/4 Degree
1000'	3/4 "
1500'	3/4 "
2000'	1/4 "
2500'	3/4 "
3000'	1/4 "

**RECEIVED**  
STATE CORPORATION COMMISSION

MAR 19 1962

CONSERVATION DIVISION  
Wichita, Kansas

## PLUGGING BACK RECORD

Date Commenced: October 23, 1958  
Date Completed: November 4, 1958

Plugged back from 3741' to 3735'

PB ID-3735'

Production Before: 4 barrels of oil and 396 barrels of water  
Production After: FOB 24 hours, 48 barrels of oil and 300 barrels water

Producing from open hole

Producing Formations: Arbuckle Lime

Moved in and rigged up cable tools of W. L. Copeland Drilling Company on October 23, 1958. Pulled rods and 2" tubing and cleaned out to bottom. On October 24, ran 2" tubing and set Halliburton RTTS packer at 3685'. Filled annulus with 20 barrels of oil, used 90 barrels of oil to circulate out all water. Pressured annulus to 300', input below packer 2 barrels of oil per minute at 1300' pressure. Ran Diesel Oil Cement job and cemented Arbuckle Lime with 57 sacks of cement and 300 gallons of No. 2 diesel fuel. Estimated 40 sacks of cement below packer at 1600', reversed out estimated 17 sacks of cement. Finished cementing at 2:00 p.m. 10/24/58. Pulled 2" tubing and packer and shut down for cement to set.

On October 25, snubbed the hole down and cleaned out to 3737'. Bailed the hole dry and tested 6 hours, 15 gallons of oil and 3 gallons of water per hour. Ran 2" tubing and filled hole with 84 barrels of oil. Treated with 200 gallons of Dowell HCA acid as follows:

ACID TREATMENT NO. 2 - Between 3741' and 3737'

Treatment put in 10/27/58 by Dowell Inc., using 200 gallons of acid and 99 barrels of oil to fill hole and flush.

TIME	CP	OP	REMARKS
3:05 pm	100'	100'	Filled hole with 84 barrels of oil
3:08 pm			Start acid in tubing
3:20 pm	75'	0'	Start oil to spot acid
3:25 pm	100'	50'	Acid to bottom
4:20 pm	250'	175'	
4:45 pm	125'	75'	
4:54 pm	Var.	Var.	Acid in formation

Snubbed through 2" tubing 4 hours, 84 barrels of oil used in treating. Then snubbed 11 hours, 10 barrels of oil and 100 barrels of water. Ran rods and FOB 15 hours, 7 barrels of oil and 250 barrels of water. On October 29, pulled rods and 2" tubing and plugged back with 20 gallons of Dowell Cement, plugged back to 3734'±.

On October 31, snubbed through 5 1/2" casing 5 hours, 90 barrels of oil used in leading hole to plug back with trace of water. Bailed hole dry, while bailing, cleaned out to 3741'. Bailed 7 hours, 1 1/2 gallons of oil and 3 1/2 gallons of water per hour. Plugged back with 1 sack of Cal-Seal from 3741' to 3732' and 5 1/2" casing tested dry. Drilled Cal-Seal plug from 3732' to 3735'.

PLUGGED BACK TOTAL DEPTH 3735'.

Dumped 1 barrel of Halliburton 15% acid down 5 1/2" casing. Washed formation 4 hours, then bailed hole dry. Bailed and tested 5 hours, 4 gallons of oil per hour with trace of water. Dumped 2 barrels of 15% acid down 5 1/2" casing, then filled hole with 87 barrels of oil. Let set 2 hours, then displaced acid with 5 barrels of oil, maximum CP-200'. Snubbed through 5 1/2" casing 3 hours, 92 barrels of lead oil, show of water. Snubbed through 5 1/2" casing 13 hours, 24 barrels of oil and 230 barrels of salt water. Ran 2" tubing and rods and FOB 9 hours, 24 barrels of oil and 151 barrels of water. On November 4, FOB 24 hours, 48 barrels of oil and 300 barrels of water.

RECEIVED  
STATE CORPORATE COMMISSION

MAR 19 1962

CONSERVATION DIVISION  
Wichita, Kansas

# SKELLY OIL COMPANY

## CHANGE IN WELL RECORD

Give complete description of all cleaning out, deepening, plugging back and fishing jobs, changes in casing, material lost in hole, etc, not recorded in original well record.

LEASE NAME M. L. Casey  
 SEC. 33 T. 9S R. 19W  
 BLOCK \_\_\_\_\_ SURVEY \_\_\_\_\_

WELL NO. 2 DISTRICT Kansas  
 STATE Kansas

### TYPE OF WORK TEST ADDITIONAL ZONES

Date commenced October 18, 1961 Date completed October 24, 1961  
 Deepened from \_\_\_\_\_ to \_\_\_\_\_ Total Depth 3701'  
 Plugged back from 3735' to 3701' P.B.T.D. \_\_\_\_\_  
 Cleaned out from \_\_\_\_\_ to \_\_\_\_\_  
 Production before 3 bbls. oil 297 bbls. water \_\_\_\_\_ cu. ft.  
 Tools owned by; \_\_\_\_\_ Kind used; Cable No. days rig time; 6  
 Cost of Job \$ \_\_\_\_\_ Revised Estimated Payout (Mos.) \_\_\_\_\_

### TREATMENT RECORD

DATE	TYPE TREATMENT	INTERVAL TREATED	AMOUNT OF TREATMENT

**RECEIVED**  
STATE COMMISSION

MAR 19 1962

### CHANGES IN CASING RECORD

STRINGS	SIZE	WHERE SET (Depth)	CEMENTING RECORD		REMARKS
			Sacks Used	Top Cem't. Bh'd. Cas'g.	
Production					
Liner					Top liner;

**CONSERVATION DIVISION**  
STATE OF KANSAS

SIZE	WT.	THDS.	KIND	COND.	LEFT IN				PULLED OUT			
					Jts.	LTM	In.	WTM	Jts.	LTM	In.	WTM
<u>5 1/2" casing perforations open</u>												
<u>Above PP TD: 3192'-3200'/32 holes; 3577'-3588'/44 holes; 3636'-66'/40 holes;</u>												
<u>Below PP TD: None</u>												

### PRODUCING FROM

Shut down for orders

FORMATION \_\_\_\_\_ thru OPEN HOLE PERFORATIONS TOP \_\_\_\_\_ BOTTOM \_\_\_\_\_ Total No. Shots \_\_\_\_\_

REMARKS (Give review of work performed and any other comment of interest)

On October 18, 1961, moved in and rigged up cable tools, pulled rods and 2 1/2" tubing. Set 5 1/2" Baker bridging plug at 3715'.

PERFORATION JOB NO. 1 - Conglomerate - 3656'-3672'  
5 1/2" casing perforated by Jetwell with 4 holes per foot:

3666'-3672' - 6' - 24 jet holes - No shows  
 3656'-3666' - 10' - 40 jet holes - No shows  
 16'      64

Plugged back with 1 sack of Cal-Seal from 3715' to 3701'. Ran 2" tubing and set 5 1/2" packer at 3642'.

TREATMENT NO. 3 - (Acid) - 3656'-3672'

10/19/61 treated by Halliburton with 500 gallons of 15% acid, used 90 barrels water, maximum TP-750#, time 50 minutes, pressure dropped to 0# in 10 minutes.

Swabbed through 2" tubing 5 hours, no oil and 56 barrels water used in treatment. Packer leaking. Pulled tubing and packer. Swabbed through 5 1/2" casing 2 hours, no oil or gas shows and 34 barrels water used in treatment; bailed 4 hours, 16 gallons formation oil and 4 barrels acid water.

Ran 2" tubing with 5 1/2" Halliburton RTTS packer, set packer at 3623'.

TREATMENT NO. 4 - (Hydrofrac) - 3656'-3672'

10/21/61 treated by Halliburton using 60 barrels water to fill annulus, pressured to 350#, pumped 15 barrels oil through 2" tubing at 2 barrels per minute at 2400#, mixed 60 barrels kerosene with 2000# of 20/40 frac sand and 500# of No-O-Gel, 210 gallons of F-10 and 200# of caustic, pressured 2300#, flushed with 50 barrels crude oil, maximum TP-2750#, broke to 2200#, finished at 750#, time 17 minutes.

Released 450#-TP with approximately 10 barrels back flow. Pulled tubing and packer. Swabbed, bailed, and cleaned out hole to 3640'. Swabbed through 5 1/2" casing 15 hours, 46 barrels of oil used in treatment and 60 barrels of water.

See

(Topeka Line)  
**PERFORATION JOB NO. 2 - (Lensing Line) - 3192'-3588'**  
 5 1/2" casing perforated by Jetwell with 4 holes per foot:

3192'-3200' - 8' - 32 jet holes  
 3577'-3588' - 11' - 44 jet holes - No fluid change

Ran 2" tubing and set 5 1/2" Halliburton HMI straddle packers with bottom packer at 3599' and top packer at 3558'.

**TREATMENT NO. 5 - (Acid) - 3577'-3588'**  
 10/23/61 treated by Halliburton through 2" tubing with 500 gallons of 15% penetrating acid, maximum TP-1000#, broke to 300#, finished at 0#, flushed with 15 barrels of water, time 7 minutes.

Swabbed through tubing 1 hour, no oil and 15 barrels of water used in treatment. Swabbed through tubing 12 hours, no oil and 48 barrels of formation water.

Raised tubing and reset 5 1/2" HMI straddle packers with bottom packer set at 3217' and top packer at 3176'.

**TREATMENT NO. 6 - (Acid) - 3192'-3200'**  
 10/24/61 treated through 2" tubing by Halliburton with 500 gallons of 15% penetrating HMI acid, maximum TP-800#, broke to 300#, finished on Vac., flushed with 15 barrels of water, time 30 minutes.

Swabbed through 2" tubing 1 hour, no oil and 15 barrels of water used in treatment. Swabbed through tubing 10 hours, no oil and 57 barrels of formation water. Pulled tubing and packers and moved out cable tools.

Shut down for orders.

**PLUGGED BACK TOTAL DEPTH 3701'**

# SKELLY OIL COMPANY

## CHANGE IN WELL RECORD

Give complete description of all cleaning out, deepening, plugging back and fishing jobs, changes in casing, material lost in hole, etc, not recorded in original well record.

LEASE NAME M. L. Conroy  
 SEC. 33 T. 9S R. 19W  
 BLOCK \_\_\_\_\_ SURVEY \_\_\_\_\_

WELL NO. 2 DISTRICT Kansas  
 STATE Kansas

### TYPE OF WORK PLUG AND ABANDON

Date commenced February 8, 1962 Date completed February 10, 1962  
 Deepened from \_\_\_\_\_ to \_\_\_\_\_ Total Depth \_\_\_\_\_  
 Plugged back from 3701' to Surface P.B.T.D. \_\_\_\_\_  
 Cleaned out from \_\_\_\_\_ to \_\_\_\_\_  
 Production before 1070 bbls. oil \_\_\_\_\_ bbls. water \_\_\_\_\_ cu. ft.  
 Production after \_\_\_\_\_ bbls. oil \_\_\_\_\_ bbls. water \_\_\_\_\_ cu. ft.  
 Tools owned by: Ace Pipe Service Kind used: Pulling mach. No. days rig time 10  
 Cost of Job \$ \_\_\_\_\_ Revised Estimated Payout (Mos.) \_\_\_\_\_

### TREATMENT RECORD

DATE	TYPE TREATMENT	INTERVAL TREATED	AMOUNT OF TREATMENT

### CHANGES IN CASING RECORD

STRINGS	SIZE	WHERE SET (Depth)	CEMENTING RECORD		REMARKS
			Sacks Used	Top Cem't. Bh'd. Cas'g.	
Production					
Liner					Top liner;

SIZE	WT.	THDS.	KIND	COND.	LEFT IN				PULLED OUT					
					Jts.	Feet	LTM	In.	Jts.	Feet	LTM	In.		
<u>5-1/2</u>	<u>19 3/8</u>	<u>22</u>	<u>355 R2 SS</u>	<u>0</u>	<u>30</u>	<u>916</u>	<u>0</u>	<u>925</u>	<u>0</u>	<u>08</u>	<u>2815</u>	<u> </u>	<u>2834</u>	<u> </u>

### PRODUCING FROM

FORMATION \_\_\_\_\_ thru OPEN HOLE PERFORATIONS TOP \_\_\_\_\_ BOTTOM \_\_\_\_\_ Total No. Shots \_\_\_\_\_

REMARKS (Give review of work performed and any other comment of interest)

As the Arbuckle line zone is depleted and further testing of probable producing zones was negligible, and as the well is not required for disposal or secondary recovery purposes, regular authority was granted to plug and abandon it.

2/8/62 moved in and rigged up plugging machine and plugged the well as follows:

Sand 3701' to 3180'  
 5 sacks of cement 3180' to 3140'

Shot off 5 1/2" casing at 2811'. Pulled 2834' of 5 1/2" casing.

Mud 3140' to 550'  
 20 sacks common cement 550' to 490'  
 10 sacks Halex Gel 490' to 180'  
 20 sacks common cement 180' to 120'  
 Mud 120' to 40'  
 Rock 40' to 30'  
 10 sacks common cement 30' to 6'  
 Surface soil 6' to Surf.

Plugged and abandoned February 10, 1962.

**RECEIVED**  
 STATE OIL AND GAS COMMISSION  
 MAR 19 1962  
 CONSERVATION DIVISION  
 Wichita, Kansas