


STATE OF KANSAS
STATE CORPORATION COMMISSION

WELL PLUGGING RECORD

Give All Information Completely
Make Required Affidavit
Mail or Deliver Report to
Conservation Division
State Corporation Comm.
245 North Water
Wichita, KS 67202

Rooks County, Sec. 33 Twp. 9 Rge. 19 W
Location as "NE/CNW $\frac{1}{4}$ SW $\frac{1}{4}$ " or footage from lines _____
660'/EL, 990'/SL
Lease Owner Dreiling Ltd. of Colorado
Lease Name Glaze Well No. 1
Office Address 410 - 17th St., Suite 1140, Denver, Co. 80202
Character of Well (Completed as Oil, Gas or Dry Hole) _____
Dry Hole

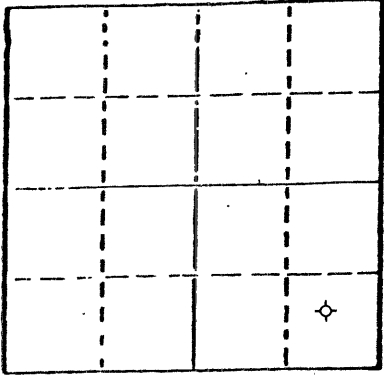

Locate well correctly on above Section Plat

Date Well completed July 6 19 82
Application for plugging filed July 13 19 82
Application for plugging approved July 6 19 82
Plugging commenced July 6, 8:15 AM 19 82
Plugging completed July 6, 10:15 AM 19 82
Reason for abandonment of well or producing formation _____
Non-productive
If a producing well is abandoned, date of last production _____
None 19

Was permission obtained from the Conservation Division or its agents before plugging was commenced? Yes

Name of Conservation Agent who supervised plugging of this well Dennis Hammel
Producing formation _____ Depth to top _____ Bottom _____ Total Depth of Well 3760'
Show depth and thickness of all water, oil and gas formations.

OIL, GAS OR WATER RECORDS

CASING RECORD

FORMATION	CONTENT	FROM	TO	SIZE	PUT IN	PULLED OUT
				8-5/8	217'	None

Describe in detail the manner in which the well was plugged, indicating where the mud fluid was placed and the method or methods used in introducing it into the hold. If cement or other plugs were used, state the character of same and depth placed, from _____ feet to _____ feet for each plug set. Hole full of heavy mud. Cement plugs with 135 sacks of 50/50 poxmix with 4% gel 3% cc, cement through drill pipe as follows:

- 1st cement plug at 925' with 70 sacks
- 2nd cement plug at 220' with 40 sacks
- 3rd 8-5/8 wood and rubber plug with solid hull bridge at 40' with 10 sacks
- 5 sacks in mouse hole
- 10 sacks in rathole

(If additional description is necessary, use BACK of this sheet)

Name of Plugging Contractor Halliburton

STATE OF Colorado COUNTY OF Denver, ss.
Floyd H. Hoffman (employee of owner) or (owner or operator)
of the above-described well, being first duly sworn on oath, says: That I have knowledge of the facts, statements, and matters herein contained and the log of the above-described well as filed and that the same are true and correct. So help me God.

(Signature) Floyd H. Hoffman
410 - 17th St., Suite 1140, Denver, Co. 80202
(Address)

SUBSCRIBED AND SWORN TO before me this 26th day of July, 19 82

Lorraine C. Murphy
Notary Public.

My commission expires 9-2-83

RECEIVED
STATE CORPORATION COMMISSION

JUL 28 1982
7-28-82
CONSERVATION DIVISION
Wichita, Kansas