


STATE OF KANSAS
STATE CORPORATION COMMISSION
200 Colorado Derby Bldg.
Wichita, Kansas 67202

Form CP-4
Rev. 12-15-80

WELL PLUGGING RECORD

Give All Information Completely
Make Required Affidavit

COUNTY Rooks SEC. 33 TWP. 9S RGE. 19W&W
Location as in quarters or footage from lines:
C N/2 N/2 SW

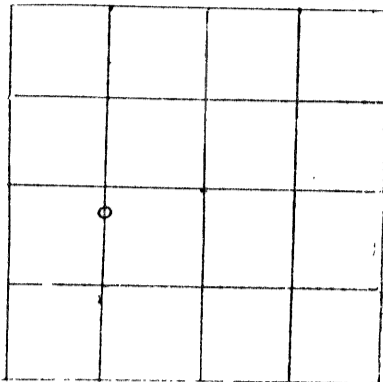

Locate Well
correctly on above
Section Platt.

Lease Owner American Energies Corporation
Lease Name Casey Well No. 1
Office Address 575 Fourth Financial Center, Wichita, KS 67101
Character of Well (Completed as Oil, Gas or Dry Hole): Dry Hole
Date Well Completed October 21, 1982
Application for plugging filed October 21, 1982
Plugging commenced October 21, 1982
Plugging completed October 21, 1982
Reason for abandonment of well or producing formation _____

Was permission obtained from the Conservation Division or it's
Agent's before plugging was commenced? yes

Name of Conservation Agent who supervised plugging of this well Marion Smith
Producing formation _____ Depth to top _____ bottom _____ T.D. 3200

Show depth and thickness of all water, oil and gas formations.

OIL, GAS OR WATER RECORDS

Casing Record

Formation	Content	From	To	Size	Put in	Pulled Out
Surface	shale	0	208	8-5/8"	204	none
	cemented with 135		60/40 poz.		2% gel, 3% cc	
	plug down at 1:15	a.m.	10-17-82		by Sun.	
	cement did circ.					

Describe in detail the manner in which the well was plugged, indicating where the mud fluid was placed and the method or methods used in introducing it into the hold. If cement or other plugs were used, state the character of same and depth placed, from _____ feet to _____ feet for each plug set.

Plugged with 180 sx 50/50 pos. 4% gel, 3% cc
20 sx @ 1640'
100 sx @ 1000'
40 sx @ 200'
10 sx @ 40' w/plug
10 sx circ in rat hole plug down at 3 p.m. 10-21-82

Rec'd
10-26-82

(If additional description is necessary, use BACK of this sheet)

Name of Plugging Contractor J. W. DRILLING CO., INC.

STATE OF KANSAS COUNTY OF SEDGWICK, ss.

Jon T. Williams, Jr. (employee of owner) or (owner or operator) of the above-described well, being first duly sworn on oath, says: That I have knowledge of the facts, statements, and matters herein contained and the log of the above-described well as filed and that the same are true and correct. So help me God.

(Signature) Jon T. Williams, Jr.
200 East First, Suite 500, Wichita, KS
(Address)

My Commission expires: January 14, 1985
Subscribed and sworn to before me this 21st day of October, 1982
Geraldine Stewart
Geraldine Stewart Notary Public.

