

CARD MUST BE TYPED

State of Kansas

CARD MUST BE SIGNED

NOTICE OF INTENTION TO DRILL

(see rules on reverse side)

Expected Spud Date.....

APRIL 6, 1987

month day year

API Number 15—

107-22,845-00-00

OPERATOR: License #

#3342

E/2 SW SE Sec. 10 Twp. 20 S, Rg. 22

Name.....

ROGER LEENERTS DBA Tiger Oil Co.

Address.....

P. O. BOX 793 #13 IMPERIAL POINT DRIVE

City/State/Zip.....

LAKE OZARK, MO 65049

Contact Person.....

ROGER LEENERTS

Phone.....

314-365-6968

CONTRACTOR: License #

#6451

Name.....

BIG E DRILLING

City/State.....

CENTERVILLE, KS 66014

Well Drilled For: Well Class: Type Equipment:

☒ Oil	☐ Storage	☒ Infield	☐ Mud Rotary
☐ Gas	☐ Inj	☐ Pool Ext.	☒ Air Rotary
☐ OWWO	☐ Expl	☐ Wildcat	☐ Cable

If OWWO: old well info as follows:

Operator.....

Well Name.....

Comp Date..... Old Total Depth.....

I certify that well will comply with K.S.A. 55-101, et seq., plus eventually plugging hole to KCC specifications.

Date..... Signature of Operator or Agent.....

Greg Engler

AS AGENT

For KCC Use:

Conductor Pipe Required..... feet; Minimum Surface Pipe Required..... feet per Alt.

This Authorization Expires..... Approved By.....

Ft. from South Line of Section

Ft. from East Line of Section

(Note: Locate well on Section Plat on reverse side)

Nearest lease or unit boundary line..... feet

County.....

Lease Name..... Well #.....

Ground surface elevation..... feet MSL

Domestic well within 330 feet:.....yes.....no

Municipal well within one mile:.....yes.....no

Depth to bottom of fresh water.....

Depth to bottom of usable water.....

Surface pipe by Alternate:.....

Surface pipe planned to be set.....

Conductor pipe required.....

Projected Total Depth..... feet

Formation.....

20

SQUIRREL

AS AGENT

20

4-3-87




Must be filed with the K.C.C. five (5) days prior to commencing well
This card void if drilling not started within six (6) months of date received by K.C.C.

Important procedures to follow:

1. Notify District office before setting surface casing.
2. Set surface casing by circulating cement to the top.
3. File completion forms ACO-1 with K.C.C. within 120 days of well spud date, following instructions on ACO-1, side 1, and including copies of wireline logs.
4. Notify District office 48 hours prior to old well workover or re-entry.
5. Prior to filing Intent, prepare a proposed plugging plan in case well is D & A, then obtain approval of plan when calling district office prior to setting surface pipe.
6. Submit plugging report (CP-4) to K.C.C. after plugging is completed.
7. Obtain an approved injection docket number before disposing of salt water.
8. Notify K.C.C. within 10 days when injection commences or terminates.
9. If an alternate 2 completion, cement in the production pipe from below any usable water to surface within 120 days of spud date.

A Regular Section of Land

1 Mile = 5,280 Ft.

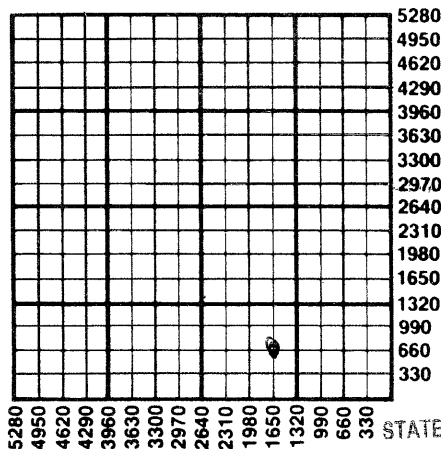

RECEIVED

STATE CORPORATION COMMISSION

APR 3 1987
4-3-87
CONSERVATION DIVISION
Wichita, Kansas

State Corporation Commission of Kansas
Conservation Division
200 Colorado Derby Building
Wichita, Kansas 67202-1212
(316) 263-3238