

API NUMBER 15-167-01651-00-60

LEASE NAME Landry

WELL NUMBER 2

 Ft. from S Section Line

 Ft. from E Section Line

SEC. 14 TWP. 9S RGE. 19W (E or W)

COUNTY Rooks

Date Well Completed

Plugging Commenced 7-12-90

Plugging Completed 7-25-90

TYPE OR PRINT
 NOTICE: Fill out completely
 and return to Cons. Div.
 office within 30 days.

LEASE OPERATOR Phillips Petroleum Company

ADDRESS Box 20-A Rt #3 Great Bend, KS. 67530

PHONE# (316) 793-8421 OPERATORS LICENSE NO. 5229

Character of Well Oil

(Oil, Gas, D&A, SWD, Input, Water Supply Well)

The plugging proposal was approved on (date)

by (KCC District Agent's Name).

Is ACO-1 filed? If not, is well log attached?

Producing Formation Depth to Top Bottom T.D. 3479'

Show depth and thickness of all water, oil and gas formations.

OIL, GAS OR WATER RECORDS | CASING RECORD

Formation	Content	From	To	Size	Put in	Pulled out
				8 5/8"	1464'	none
				5 1/2"	3477'	2544'

Describe in detail the manner in which the well was plugged, indicating where the mud fluid was placed and the method or methods used in introducing it into the hole. If cement or other plugs were used, state the character of same and depth placed, from feet to feet each set.
Sanded bottom to 3420' ran 5 sacks cement. Shot pipe @ 2600',
2544'. Down 8 5/8" casing @ 700# Max pressure. Mixed 5 sacks
hulls with 225 sacks 65/35 poz 8% gel and shut in @ 400#.

(If additional description is necessary, use BACK of this form.)

Name of Plugging Contractor KELSO CASING PULLING, INC. License No. 6050

Address P.O. Box 347 Chase, Kansas 67524

NAME OF PARTY RESPONSIBLE FOR PLUGGING FEES: Phillips Petroleum Company RECEIVED

STATE OF Kansas COUNTY OF Rice, ss.

R. Darrell Kelso (Employee of Operator) or (Operator) of
 above-described well, being first duly sworn on oath, says: That I have knowledge of the facts,
 statements, and matters herein contained and the log of the above-described well as filed that
 the same are true and correct, so help me God.


(Signature) *R. Darrell Kelso*

(Address) P.O. Box 347 Chase, KS. 67524

SUBSCRIBED AND SWORN TO before me this 14 day of Sept., 19 90

Irene Herzberg
 Notary Public


My Commission Expires:

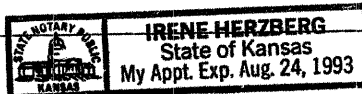

15-169-01651-00-08

WELL SCHEMATIC

GL 2055
 DF 2058
 KB 2059.5
 PBTD _____
 TD 3479

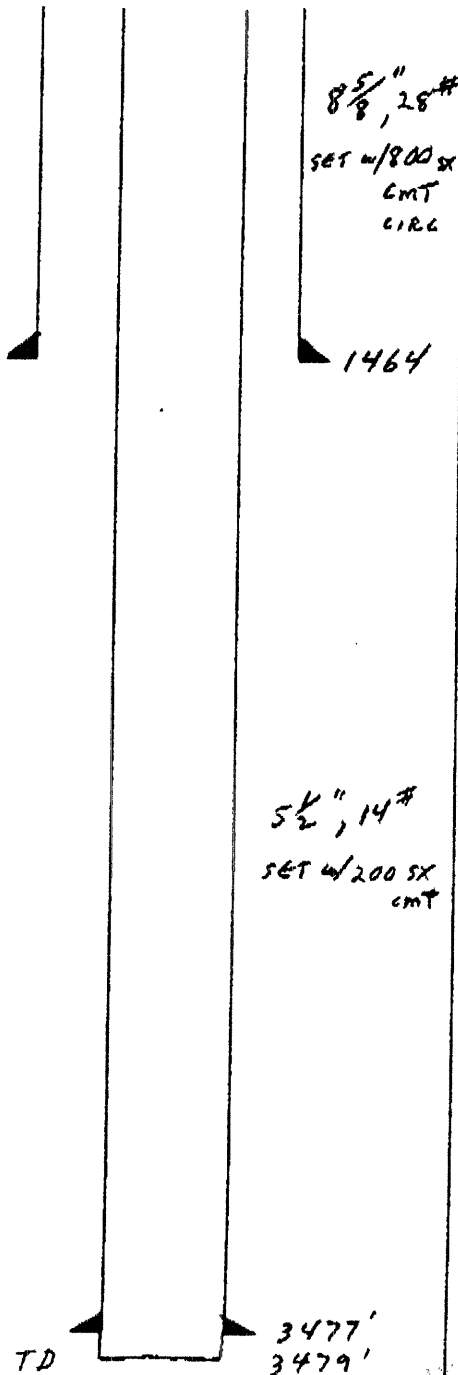

WELL DATA

WELL LOCATION LANDRY No. 2 STATUS SD OIL
NW SE NW
SEC 14 - T9S - R19W
ROOKS COUNTY, KS
 SPUD _____
 COMPLETED _____
 IP _____

CASING	OD	WT	CEMENT	FROM	TO
	<u>8 5/8"</u>	<u>28#</u>	<u>800 SX</u>	<u>1464</u>	<u>SURF.</u>
	<u>5 1/2"</u>	<u>14#</u>	<u>200 SX</u>	<u>3477</u>	
TUBING					

PERFS.	ZONE	TYPE	INTERVAL	SPF
	<u>ARBuckle</u>	<u>OPEN HOLE</u>	<u>3477-79'</u>	

LOGS	TYPE	DATE	COMPANY	FOOTAGE

WELL TEST	DATE	BOPD	MCFGPD	BWPD

PREPARED BY: DAR
 DATE: 5/22/90

JUN 7 1990