


WELL PLUGGING RECORD

Give All Information Completely
Make Required Affidavit
Mail or Deliver Report to:
Conservation Division
State Corporation Commission
211 No. Broadway
Wichita, Kansas

Rooks County, Sec. 14 Twp. 9S Rge. (E) 19(W)

Location as "NE/CNW/SW" or footage from lines SE NW NW
Lease Owner Phillips Petroleum Co.
Lease Name Landry Well No. 4
Office Address Box 287 - Great Bend, Kans.
Character of Well (completed as Oil, Gas or Dry Hole) Oil
Date well completed Oct. 19 19 49
Application for plugging filed May 23 19 63
Application for plugging approved May 29 19 63
Plugging commenced June 10 19 63
Plugging completed June 12 19 63
Reason for abandonment of well or producing formation Unprofitable to operate

NORTH

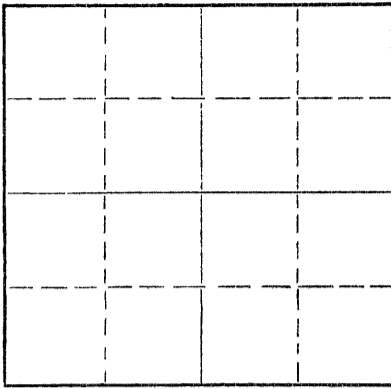

Locate well correctly on above
Section Plat

If a producing well is abandoned, date of last production April 10 19 63
Was permission obtained from the Conservation Division or its agents before plugging was commenced? Yes

Name of Conservation Agent who supervised plugging of this well Eldon Petty
Producing formation Arbuckle lime Depth to top 3480 Bottom NR Total Depth of Well 3507 Feet
Show depth and thickness of all water, oil and gas formations.

OIL, GAS OR WATER RECORDS

CASING RECORD

FORMATION	CONTENT	FROM	TO	SIZE	PUT IN	PULLED OUT
Arbuckle lime	Oil	3480'		8-5/8"	1489'	None
				5-1/2"	3478'	2485'

Note: Well deepened in Arb. 3483' to 3507' and squeezed. Well then plugged back to LKC & Topeka, but production not commercial.

Describe in detail the manner in which the well was plugged, indicating where the mud fluid was placed and the method or methods used in introducing it into the hole. If cement or other plugs were used, state the character of same and depth placed, from _____ feet to _____ feet for each plug set.

Cast iron bridge plug set @ 3200'. Plugged back with sand from 3200' to 3120' and four sacks cement from 3120' to 3088'. Shot off & pulled 5 1/2" casing, and mudded hole to 600' - spotted 25 sacks cement from 600' to 520' - mudded hole to 75' and spotted 25 sacks cement from 75' to surface.

RECEIVED
STATE CORPORATION COMMISSION

JUN 17 1963

6-17-63

CONSERVATION DIVISION
Wichita, Kansas

(If additional description is necessary, use BACK of this sheet)

Name of Plugging Contractor Forbes Casing Pulling Co.
Address Great Bend, Kans.

STATE OF Kansas, COUNTY OF Barton, ss.
M. E. Michael (employee of owner) or (owner or operator) of the above-described

well, being first duly sworn on oath, says: That I have knowledge of the facts, statements, and matters herein contained and the log of the above-described well as filed and that the same are true and correct. So help me God.

(Signature) M. E. Michael
Box 287 - Great Bend, Kansas
(Address)

SUBSCRIBED AND SWORN TO before me this 13th day of June, 19 63

My commission expires Nov. 18, 1965

Joseph M. Beck
Notary Public.

FORMATION RECORD

- Landry #4

0	580	Shale & shells
580	860	Shale
860	915	Shale & shells
915	1145	Sand
1145	1264	Shale & shells
1264	1433	Red bed & shale
1433	1474	Anhydrite
1474	1498	Red bed
1498	2255	Shale & shells
2255	3004	Lime & shale
3004	3483	Lime

RECEIVED
STATE CORPORATION COMMISSION

JUN 17 1963
6-17-63
CONSERVATION DIVISION
Wichita, Kansas