


15-163-20334-00-08

Give All Information Completely
Make Required Affidavit
Mail or Deliver Report to
Conservation Division
State Corporation Commission
245 North Water
Wichita, KS 67202

FORM CP-4

WELL PLUGGING RECORD

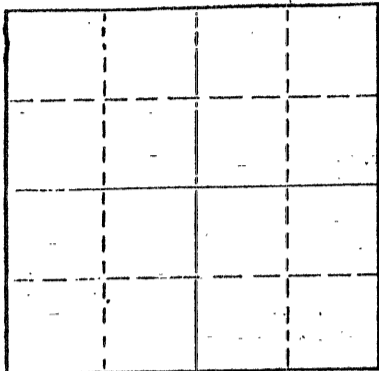

Locate well correctly on above Section Plat

Rooks _____ County. Sec. 9 Twp. 9 Rge. 20 (E) _____ (W)X
Location as "NE/CNW/SW" or footage from lines S/2/NE/SW
Lease Owner Woodman-Tannitti Drilling Co.
Lease Name WHISMAN Well No. 1
Office Address Box 308, Great Bend, Kansas 67530
Character of Well (completed as Oil, Gas or Dry Hole) _____
Date well completed _____ 19____
Application for plugging filed _____ June 29 1976
Application for plugging approved _____ 19____
Plugging commenced _____ July 7 1976
Plugging completed _____ July 14 1976
Reason for abandonment of well or producing formation depleted
If a producing well is abandoned, date of last production _____ 19____
Was permission obtained from the Conservation Division or its agents before plugging was commenced? yes

Name of Conservation Agent who supervised plugging of this well Leo Massey
Producing formation _____ Depth to top _____ Bottom _____ Total Depth of Well 3675 Feet
Show depth and thickness of all water, oil and gas formations _____

OIL, GAS OR WATER RECORDS

CASING RECORD

FORMATION	CONTENT	FROM	TO	SIZE	PUT IN	PULLED OUT
				8 5/8"	202'	0
				5 1/2"	3671'	2,612.18'

Describe in detail the manner in which the well was plugged, indicating where the mud fluid was placed and the method or methods used in introducing it into the hole. If cement or other plugs were used, state the character of same and depth placed, from _____ feet to _____ feet for each plug set.

Plugged bottom back to 3375' with plug at 3400', sand to 3375' and 5 sacks cement.
Shot pipe @ 2719' and 2621'.
Pulled a total of 81 joints of 5 1/2" casing.
Squeezed well with 3 sacks hulls, 30 sacks gel and 120 sacks pozmix w/ 6% added gel.

(If additional description is necessary, use BACK of this sheet)

Name of Plugging Contractor Rockhold Engineering, Inc.
Address P.O. Box 698, Great Bend, Kansas 67530

STATE OF Kansas COUNTY OF Barton ss.

James W. Rockhold (employee of owner) or (owner or operator) of the above-described well, being first duly sworn on oath, says: That I have knowledge of the facts, statements, and matters herein contained and the log of the above-described well as filed and that the same are true and correct. So help me God.



(Signature) James W. Rockhold
Box 698, Great Bend, Kansas 67530
(Address)

SUBSCRIBED AND SWORN TO before me this 16th day of July, 1976

My commission expires May 21, 1980

Marla K. Haslam
Marla K. Haslam Notary Public

K. T. WOODMAN
REG. PHONE AM 5-3572
OFFICE PH. AM 5-7650
WICHITA, KANSAS

15-163-20334-00-00

D. J. IANNITTI
TELEPHONE 653-2381
HOISINGTON, KANSAS

WOODMAN & IANNITTI DRILLING COMPANY
Rotary Drilling Contractors

706 UNION NATIONAL BUILDING
WICHITA, KANSAS 67202

December 11, 1970

Company; Clinton Oil Company and Woodman & Iannitti
Farm; Whisman
Location; C S/2 NE SW
Section; 9-9-20W
County; Rooks
Contractor; Woodman & Iannitti Drilling Co.
Comm; Dec. 3, 1970
Compl; Dec. 11, 1970
Total Depth; 3675
Casing; 8 5/8" at 202 with 140 sacks
5 1/2" at 3671 with 150 sacks

Figures Indicate Bottom Of Formations:

60	Post Rock & Shale.
160	Sand & Shale
203	Shale
530	Shale
800	Shale
1180	Streck Of Sand & Shale
1330	Sand
1475	Red Bed
1666	Red Bed
1672	Chalk
1704	Anhy
1890	Shale & Shells
2260	Lime & Shale
2430	Lime
2625	Lime
2815	Shale
3000	Lime & Shale
3140	Lime & Shale
3220	Lime
3320	Lime
3400	Lime
3450	Lime
3470	Lime
3500	Lime
3505	Lime
3588	Lime
3600	Lime
3617	Lime
3657	Lime & Shale
3675	Dolomite

I certify the above to be a true and correct copy of the driller's log and the geological notes to the best of my knowledge and belief.