

WELL PLUGGING RECORD

Give All Information Completely
Make Required Affidavit
Mail or Deliver Report to
Conservation Division
State Corporation Comm.
200 Colorado Derby Bldg.
202 W. 1st St.
Wichita, KS 67202

Rooks County Sec. 9 Twp. 9S Rge. 20 E/W
Location as "NE/CNW/SW" or footage from lines

SW SW NE

Lease Owner Liberty Enterprises, Inc.

Lease Name Wright Well No #1

Office Address 308 West Mill Plainville, Ks 67663

Character of Well (Completed as Oil, Gas or Dry Hole)

Dry Hole

Date Well completed 8-8 19 81

Application for plugging filed 8-8 19 81

Application for plugging approved 8-8 19 81

Plugging commenced 12:00 P.M. 8-8 19 81

Plugging completed 1:30 P.M. 8-8 19 81

Reason for abandonment of well or producing formation

No Commercial Production

If a producing well is abandoned, date of last production 19


Was permission obtained from the Conservation Division or its agents before plugging was commenced? Yes

Name of Conservation Agent who supervised plugging of this well Marion Schmidt

Producing formation Depth to top Bottom Tl. Depth of Well

Show depth and thickness of all water, oil and gas formations.

locate well correctly
on above
Section Plot

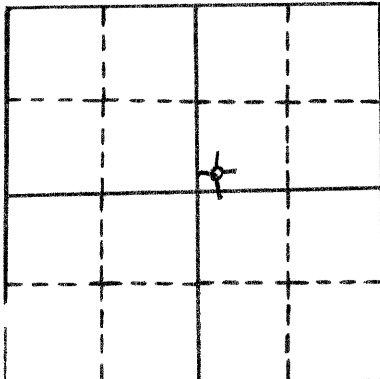

OIL, GAS OR WATER RECORDS

CASING RECORD

FORMATION	CONTENT	FROM	TO	SIZE	PUT IN	PULLED OUT
Surface Casing	common	0'	279'	8 5/8"	279'	0'

Describe in detail the manner in which the well was plugged, indicating where the mud fluid was placed and the method or methods used in introducing it into the well. If cement or other plugs were used, state the character of same and depth placed, _____ feet to _____ feet for each plug s t.

Plug #1 920' with 70 sxs

Plug #2 270' with 30 sxs

Plug #3 40' with 10 sxs

5 sxs in rathole

Total - 115 sxs 50-50 pos 4% gel 3% cc

(If additional description is necessary, use BACK of this sheet)

Name of Plugging Contractor Pioneer Drilling Com

308 West Mill Plainville, Ks 67663

STATE OF Kansas COUNTY OF Rooks, ss.


Liberty Enterprises, Inc. (employee of owner) or (owner or operator) of the above described well, being first duly sworn on oath, says: That I have knowledge of the facts, statements, and matters herein contained and the log of the above described well is filed and that the same are true and correct. So help me God.

(Signature) David R. Conner

(Address) 308 W MILL
Plainville, KS 67663

SUBSCRIBED AND SWORN TO before me this 19th day of August, 19 81

My commission expires

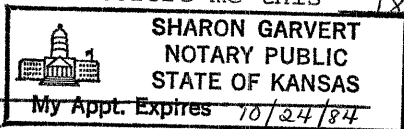

Sharon Garvert
Notary Public

RECEIVED
STATE CORPORATION COMMISSION
8/19/81
AUG 19 1981
CONSERVATION DIVISION
Wichita, Kansas

15-163-21347-00-00

W E L L L O G

OPERATOR: Liberty Enterprises, Inc.

WELL NAME: Wright #1 LOCATION: SW SW NE 9-9S-20W

COUNTY: Rooks STATE: Kansas

WELL COMMENCED: July 31, 1981 WELL COMPLETED: August 8, 1981

ELEVATION: 2163' K.B. TOTAL DEPTH: 3788'

PRODUCTION: D & A RIG NO: #1

CASING - 8 5/8": 6 Jts new 24# 272.66' set @ 279' cemented with 145 sxs common 3%cc 2%gel
5 1/2": P.D. @ 11:30 P.M. 7-31-81 did circ.

ALL MEASUREMENTS TAKEN FROM THE TOP OF ROTARY BUSHING:

FROM	TO	FORMATION	DEVIATION FROM VERTICAL	REMARKS:
0'	282'	sand and shale	282' - 3/4 degree	
282'	976'	shales and sands		
976'	1687'	sand and shales		
1687'	1727'	anhydrite		
1727'	1820'	shale and sands		
1820'	2203'	shale and sands		
2203'	2217'	shales and limes	2217' - 1 1/4 degree	
2217'	2290'	shales and limes		
2290'	2488'	shale and lime		
2488'	2627'	lime and shale		
2627'	2777'	limes and shales		
2777'	2928'	lime and shale		
2928'	3031'	lime and shale	3031' - 3/4 degree	
3031'	3105'	lime and shales		
3105'	3230'	lime and shale		
3230'	3312'	lime and shale		
3312'	3370'	lime and shale		
3370'	3414'	lime and shale		
3414'	3492'	lime and shale		
3492'	3559'	lime and shale		
3559'	3641'	lime and shale		
3641'	3675'	lime and shale		
3675'	3746'	lime and shale		
3746'	3788'	lime and shale	3788' - 1 degree	
3788'	R.T.D.			

RECEIVED
STATE CORPORATION COMMISSION
AUG 19 1981
CONSERVATION DIVISION
Wichita, Kansas

STATE OF KANSAS
COUNTY OF

The undersigned hereby certifies that to the best of his knowledge and belief, the above facts are true and correct

PIONEER DRILLING CO., INC.

By Stacy A. Wilgers

SUBSCRIBED AND SWORN TO, BEFORE ME, This 18th day of August, 1981

Sharon Garvert
NOTARY PUBLIC

