

STATE OF KANSAS
STATE CORPORATION COMMISSION


Give All Information Completely
Make Required Affidavit
Mail or Deliver Report to:
Conservation Division
State Corporation Commission
211 No. Broadway
Wichita, Kansas

WELL PLUGGING RECORD

15-163-00756-00-00

Rooks _____ County. Sec. 8 Twp. 9S Rge. 20W (E) _____ (W)
Location as "NE/CNW/SW" or footage from lines NE NW SW
Lease Owner C-G Drilling Co. & D. G. Hansen
Lease Name Thyfault "A" Well No. 1
Office Address 107 Rule Bldg., Wichita, Kansas
Character of Well (completed as Oil, Gas or Dry Hole) Dry Hole
Date well completed January 15 19 58
Application for plugging filed January 15 19 58
Application for plugging approved January 15 19 58
Plugging commenced January 15 19 58
Plugging completed January 15 19 58
Reason for abandonment of well or producing formation Too low structurally

NORTH

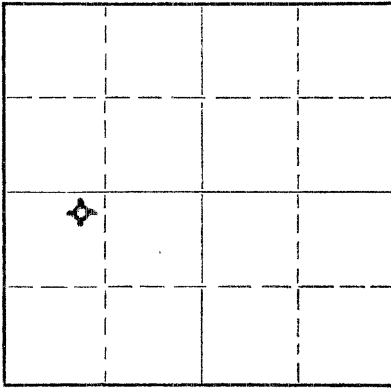

Locate well correctly on above
Section Plat

If a producing well is abandoned, date of last production _____ 19____
Was permission obtained from the Conservation Division or its agents before plugging was commenced? Yes

Name of Conservation Agent who supervised plugging of this well Eldon Petty, Hays, Kansas
Producing formation _____ Depth to top _____ Bottom _____ Total Depth of Well 3795 Feet
Show depth and thickness of all water, oil and gas formations.

OIL, GAS OR WATER RECORDS

CASING RECORD

FORMATION	CONTENT	FROM	TO	SIZE	PUT IN	PULLED OUT
				8-5/8"	172.28'	none

Describe in detail the manner in which the well was plugged, indicating where the mud fluid was placed and the method or methods used in introducing it into the hole. If cement or other plugs were used, state the character of same and depth placed, from _____ feet to _____ feet for each plug set.

Filled hole with heavy mud to 700'. Set plug. Put in 25 sacks cement. Filled to 200'. Set plug. Put in 15 sacks cement. Filled with heavy mud up to 40'. Set plug. Filled to top with 1/2 sack hulls and 10 sacks cement.

(If additional description is necessary, use BACK of this sheet)

Name of Plugging Contractor C-G Drilling Co.
Address 107 Rule Building, Wichita, Kansas

STATE OF KANSAS, COUNTY OF SEDGWICK, ss.
G. F. Galloway (employee of owner) or (owner or operator) of the above-described well, being first duly sworn on oath, says: That I have knowledge of the facts, statements, and matters herein contained and the log of the above-described well as filed and that the same are true and correct. So help me God.

(Signature) G. F. Galloway
107 Rule Building
(Address)

SUBSCRIBED AND SWORN to before me this 20th day of January, 1958

My commission expires May 20, 1959 Vicky Jacobs Notary Public.

PLUGGING
FILE SEC. 8 T. 9 R. 20W
BOOK PAGE 77 LINE 44

RECEIVED
1/22/58
JAN 22 1958
COMMISSION
DIVISION

15-163-00756-00-00

CONTRACTOR'S WELL LOG

OPERATOR C-G Drilling Co. & D. G. Hansen WELL NAME Thyfault "A" #1
LOCATION NE NW SW SEC. 8-9S-20W RIG NO. 1
COUNTY Rooks STATE Kansas
COMMENCEMENT DATE January 7, 1958 COMPLETION DATE January 15, 1958

LOG OF WELL

Elevation 2194' rotary bushing.
All measurements taken from the top of rotary bushing.

Table with columns: FROM, TO, FORMATION, DEVIATION FROM VERTICAL, REMARKS. Rows include formations like Shale-Sand, Sand, Red Bed, Anhydrite, Shale-Shell, Lime-Shale with depth measurements and deviation notes.

CASING LEFT IN HOLE AFTER COMPLETION

Ran 172.28' (9 jts.) 8-5/8" OD Surface Casing.

STATE OF KANSAS }
COUNTY OF SEDGWICK } SS.

The undersigned hereby certifies that to the best of his knowledge and belief, the above facts are true and correct.

C-G DRILLING CO.

By [Signature] G. F. Galloway

SUBSCRIBED AND SWORN TO BEFORE ME THIS 21st day of January, 1958.

[Signature] Vicky Jacobs, Notary Public

My commission expires: May 20, 1959

PLUGGING
FILE SEC 8 T 9 R 20W
BOOK PAGE 77 LINE 44

RECEIVED
CORPORATION COMMISSION
JAN 22 1958
CORPORATION DIVISION
KANSAS