


Give All Information Completely  
Make Required Affidavit  
Mail or Deliver Report to:  
Conservation Division  
State Corporation Commission  
211 No. Broadway  
Wichita, Kansas

WELL PLUGGING RECORD

NORTH

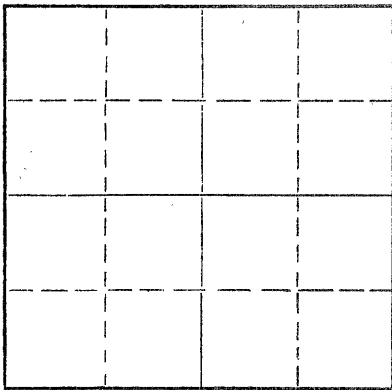

Locate well correctly on above  
Section Plat

Rooks

County. Sec. 13 Twp. 9S Rge. (E) 19 (W)

Location as "NE/CNW%SW%" or footage from lines NW SE NW

Lease Owner Bergman Oil Company

Lease Name Thyfault "B" Well No. 1

Office Address 425 Union Center, Wichita, Kansas

Character of Well (completed as Oil, Gas or Dry Hole) Dry Hole

Date well completed April 7 19 65

Application for plugging filed April 7 19 65

Application for plugging approved April 7 19 65

Plugging commenced April 7 19 65

Plugging completed April 7 19 65

Reason for abandonment of well or producing formation Dry Hole

If a producing well is abandoned, date of last production \_\_\_\_\_ 19 \_\_\_\_\_

Was permission obtained from the Conservation Division or its agents before plugging was commenced? Yes

Name of Conservation Agent who supervised plugging of this well Eldon Petty

Producing formation \_\_\_\_\_ Depth to top \_\_\_\_\_ Bottom \_\_\_\_\_ Total Depth of Well 3554 Feet

Show depth and thickness of all water, oil and gas formations.

OIL, GAS OR WATER RECORDS

CASING RECORD

FORMATION	CONTENT	FROM	TO	SIZE	PUT IN	PULLED OUT
Shela - Postrock - Shells		0	195	8 5/8	195	None

Describe in detail the manner in which the well was plugged, indicating where the mud fluid was placed and the method or methods used in introducing it into the hole. If cement or other plugs were used, state the character of same and depth placed, from Top feet to Bottom feet for each plug set.

First plug set at 540 feet with 20 sacks cement.

Second plug set at 180 feet with 20 sacks cement.

Third Plug set at 40 feet with 10 sacks cement.

RECEIVED  
STATE CORPORATION COMMISSION

APR 13 1965

4-13-65

CONSERVATION DIVISION  
Wichita, Kansas

(If additional description is necessary, use BACK of this sheet)

Name of Plugging Contractor BERGMAN DRILLING, INC. #507

Address 425 Union Center, Wichita, Kansas

STATE OF Kansas, COUNTY OF Sedgwick, ss. Harold Bergman

(~~employee of owner~~) or (owner or operator) of the above-described well, being first duly sworn on oath, says: That I have knowledge of the facts, statements, and matters herein contained and the log of the above-described well as filed and that the same are true and correct. So help me God.

(Signature) Harold Bergman  
425 Union Center, Wichita, Kansas  
(Address)

SUBSCRIBED AND SWORN TO before me this 12th day of April, 19 65

My commission expires August 2, 1966

James J. Jackson  
Notary Public.



DRILLERS' LOG

Thyfault B#1 - Bergman Oil Company  
 NW SE NW Section 13-9S-19W  
 Rooks County, Kansas

Date Commenced: March 30, 1965  
 Date Completed: April 7, 1965

Casing record: Set 195 feet 8-5/8" casing with 250 sacks cement.

0	-	70	Shale and Post Rock
70	-	195	Shale and Shells
195	-	960	Shale and Shalles
960	-	1065	Sand
1065	-	1150	Sand
1150	-	1480	Shale and Shells
1480	-	1500	Anhydrite
1500	-	1520	Anhydrite
1520	-	1875	Shale and Shells
1875	-	2080	Shale and Lime
2080	-	2250	Shale and Lime
2250	-	2400	Lime and Shale
2400	-	2575	Lime and Shale
2575	-	2725	Shale and Lime
2725	-	2850	Lime and Shale
2850	-	3008	Lime and Shale
3008	-	3115	Lime and Shale
3115	-	3175	Lime
3175	-	3255	Lime
3255	-	3310	Lime
3310	-	3354	Lime
3354	-	3420	Lime
3420	-	3470	Lime
3470	-	3500	Lime
3500	-	3530	Lime
3530	-	3532	Lime
3532	-	3536	Lime
3536	-	3544	Arbuckle
3544	-	3554	Arbuckle
3554			Rotary Total Depth

RECEIVED  
 STATE CORPORATION COMMISSION  
 APR 13 1965  
 4-13-65  
 CONSERVATION DIVISION  
 Wichita, Kansas

A F F I D A V I T

STATE OF KANSAS )  
 ) SS.  
 COUNTY OF SEDGWICK)

I, do swear that the statements and matter herein contained are true to the best of my knowledge.

BERGMAN OIL COMPANY

*[Handwritten Signature]*  
 \_\_\_\_\_

Subscribed and sworn to before me this 12th day of April, 1965.

*[Handwritten Signature]*  
 \_\_\_\_\_  
 Notary Public

My Commission Expires:  
August 2, 1966