


STATE OF KANSAS  
STATE CORPORATION COMMISSION

WELL PLUGGING RECORD

Give All Information Completely  
Make Required Affidavit  
Mail or Deliver Report to  
Conservation Division  
State Corporation Comm.  
245 North Water  
Wichita, KS 67202

Rooks County. Sec. 13 Twp. 9 Rge. 19  W  
Location as "NE/CNW $\frac{1}{4}$ SW $\frac{1}{4}$ " or footage from lines  
NW SW SE

Lease Owner Icer Addis  
Lease Name HILGERS Well No. 1  
Office Address P.O. Drawer 8038 - Wichita, Ks. 67208  
Character of Well (Completed as Oil, Gas or Dry Hole)  
Dry Hole

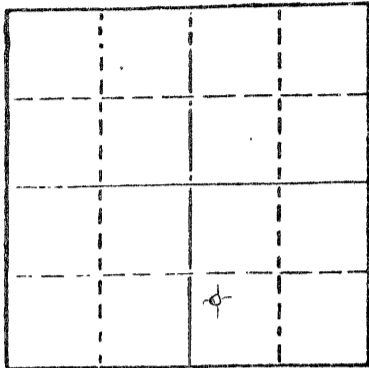

Locate well correctly on above  
Section Plat

Date Well completed June 24, 1980  
Application for plugging filed June 24, 1980  
Application for plugging approved June 24, 1980  
Plugging commenced June 24, 1980  
Plugging completed June 24, 1980  
Reason for abandonment of well or producing formation

If a producing well is abandoned, date of last production 19

Was permission obtained from the Conservation Division or its agents before plugging was commenced? yes

Name of Conservation Agent who supervised plugging of this well Marion Schmidt  
Producing formation Depth to top Bottom Total Depth of Well 3650  
Show depth and thickness of all water, oil and gas formations.

OIL, GAS OR WATER RECORDS

CASING RECORD

FORMATION	CONTENT	FROM	TO	SIZE	PUT IN	PULLED OUT

Describe in detail the manner in which the well was plugged, indicating where the mud fluid was placed and the method or methods used in introducing it into the hold. If cement or other plugs were used, state the character of same and depth placed, from feet to feet for each plug set.

Set bottom plug @ 790' w/70 sacks 50/50 pozmix, 6% Gel thru drill pipe  
Middle plug set at 180' w/20 sacks cement thru drill pipe  
Top plug set at 40' w/solid bridge of  $\frac{1}{2}$  sacks hulls & 10 sacks cement  
5 sacks cement in rat hole

RECEIVED  
STATE CORPORATION COMMISSION

JUN 26 1980  
6-26-80

(If additional description is necessary, use BACK of this sheet)  
Name of Plugging Contractor Duke Drilling Co., Inc.

STATE OF Kansas COUNTY OF Barton  
Bill Draney (employee of owner) or ~~owner or operator~~

of the above-described well, being first duly sworn on oath, says: That I have knowledge of the facts, statements, and matters herein contained and the log of the above-described well as filed and that the same are true and correct. So help me God.

(Signature) Bill Draney  
Box 823 - Great Bend, Ks. 67530  
(Address)

SUBSCRIBED AND SWORN TO before me this 25 day of June, 19 80

*Dorothy M. Wague*  
Notary Public.

My commission expires ~~XX~~ April 11, 1982

DRILLERS' WELL LOG

DATE COMMENCED: June 19, 1980  
 DATE COMPLETED: June 24, 1980

Icer Addis  
 Hilgers #1  
 NW SW SE  
 Sec. 13, T9S, R19W  
 Rocks County, Ks.

0 - 202' Surface Soil, Shale  
 202 - 1050' Shale  
 1050 - 1280' Sand & Sd. Streaks  
 1280 - 1570' Red Bed  
 1570 - 1612' Anhydrite  
 1612 - 3133' Shale  
 3133 - 3346' Lime  
 3346 - 3350' Shale  
 3350 - 3387' Lime & Shale  
 3387 - 3601' Lime  
 3601 - 3650' Lime, Chert, Congl.  
 3650' RTD

ELEVATION:

FORMATION DATA

Anhydrite	1570'
Topeka	3133'
Heebner	3346'
Toronto	3367'
Lansing - K.C.	3387'
Base K.C.	3601'
Cherty Congl.	3630'
RTD	3650'

Surface Casing: Set used  
 8-5/8" pipe at 202' w/140  
 sacks 50/50 pozmix, 2% gel,  
 3% c.c.

A F F I D A V I T

STATE OF KANSAS  
 COUNTY OF BARTON) ss

Bill Draney of lawful age, does swear and state that the facts and  
 statements herein contained are true and correct to the best of his knowledge.

Bill Draney

Subscribed and sworn to before me this 25<sup>th</sup> day of June 1980.

My Comm. Expires:

4-11-1982

Dorothy M. Haguer  
 Notary Public

JUN 26 1980  
 6-26-80

CONSERVATION DIVISION