


STATE OF KANSAS
STATE CORPORATION COMMISSION

Form CP-4

Give All Information Completely
Make Required Affidavit
Mail or Deliver Report to:
Conservation Division
State Corporation Commission
212 No. Market
Wichita, Kansas

WELL PLUGGING RECORD

NORTH

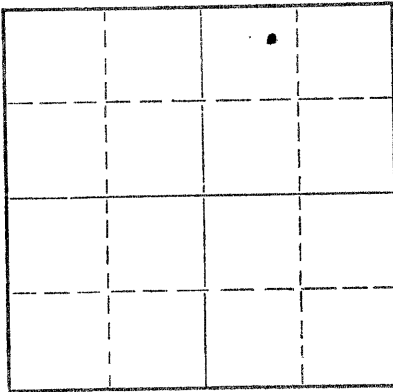

Locate well correctly on above
Section Plat

Rooks County. Sec. 13 Twp. 9 Rge. 19 (E) (W)
Location as "NE/CNW/SW" or footage from lines. NE NW NE
Lease Owner K + G Oil Co
Lease Name Nitgers Well No. 2
Office Address Box 463 Plainville Kans
Character of Well (completed as Oil, Gas or Dry Hole) Oil
Date well completed Bought Well from Union Texas Pet don't know
Application for plugging filed July 19 1968
Application for plugging approved July 15 1968
Plugging commenced July 26 1968
Plugging completed July 26 1968
Reason for abandonment of well or producing formation Very little oil

If a producing well is abandoned, date of last production June 1968
Was permission obtained from the Conservation Division or its agents before plugging was commenced? Yes

Name of Conservation Agent who supervised plugging of this well Leo Massey
Producing formation K.C. Depth to top 3225 Bottom 3470 Total Depth of Well 3500 Feet
Show depth and thickness of all water, oil and gas formations.

OIL, GAS OR WATER RECORDS

CASING RECORD

FORMATION	CONTENT	FROM	TO	SIZE	PUT IN	PULLED OUT
	RECEIVED STATE CORPORATION COMMISSION AUG 28 1968 CONSERVATION DIVISION Wichita, Kansas			5 1/2"	3497	NONE

Describe in detail the manner in which the well was plugged, indicating where the mud fluid was placed and the method or methods used in introducing it into the hole. If cement or other plugs were used, state the character of same and depth placed, from _____ feet to _____ feet for each plug set.

The well was plugged with 35 sacks of fill mixed with 10 sacks of Halls. Then a 5 1/2" plug and 70 sacks of cement was pumped. 1600 # shut in pressure 500 #

We also pumped in 30 sacks of cement between 5 1/2" + 10 3/4"

NOTE

no pipe was pulled well was squeezed to shut off Dakota leak in 5 1/2" casing

(If additional description is necessary, use Back of this sheet)

Name of Plugging Contractor Company Tools + Halliburton pump truck
Address _____

STATE OF Kansas COUNTY OF Rooks ss.

Kenneth O. Brown (employee of owner) or (owner or operator) of the above-described well being first duly sworn on oath, says: That I have knowledge of the facts, statements, and matters herein contained and the log of the above-described well as filed and that the same are true and correct. So help me God.

(Signature) Kenneth O. BrownPlainville, Ks.

(Address)

SUBSCRIBED AND SWORN to before me this 27th day of August 1968Luth E. Bridges

Notary Public.

My commission expires August 6, 1969

15-163-03045-00-00
WELL LOG BUREAU - KANSAS GEOLOGICAL SOCIETY
412 Union National Bk. Bldg., Wichita, Kansas

COPY


Company - H. H. & B. DRIG. CO.
Farm - Hilgers No. 2

SEC. 13 T. 9 R19W
NE NW NE

Total Depth. 3500' = 3497' Corrected.
Comm. 2-23-47 Comp. 3-28-47
Shot or Treated.
Contractor. H. H. & B. Drig. Co.
Issued. 4-19-47

County. Rocks

KANSAS

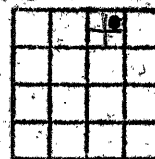

Elevation. _____

Production. Phy. Pot 324

CASING:

10 3/4" 202' cem.w/ 135 sx.
5 1/2" 3495' cem.w/ 150 sx.

Figures Indicate Bottom of Formations.

clay & sand	0-28
shale & lime shells	205
shale & shells	470
sand, shale & shells	780
sand	860
sand & shale	1090
shale	1175
red bed	1250
red bed & shale	1430
anhydrite	1460
shale	1475
shale & lime shells	1655
shale & red bed	1805
shale & shells	1945
shale & lime shells	2050
shale & lime	2215
shale & lime shells	2300
lime	2360
shale & lime	2460
lime	2530
lime & shale	2730
shale & shells	2825
shale & lime	3245
lime	3270
lime & shale	3300
lime	3445
lime & shale	3498
Arbuckle Lime	3500
Total Depth	3500 = 3497 Corr.
Tops:	
Anhydrite	1430
Lansing	3258
Arbuckle	3495

RECEIVED
STATE CORPORATION COMMISSION
JUL 15 1968
CONSERVATION DIVISION
Wichita, Kansas