

STATE OF KANSAS  
STATE CORPORATION COMMISSION


Give All Information Completely  
Make Required Affidavit  
Mail or Deliver Report to:  
Conservation Division  
State Corporation Commission  
800 Bittling Building  
Wichita, Kansas

WELL PLUGGING RECORD

Rooks County, Sec. 13 Twp. 9S Rge. 19 ~~W~~ ~~W~~

Location as "NE/CNW/SW" or footage from lines NW-NE-SE  
Lease Owner Jack Heathman & Co.  
Lease Name Hilgers Well No. #1  
Office Address 254 Washington Wichita, Kansas  
Character of Well (completed as Oil, Gas or Dry Hole) Dry hole  
Date well completed 11-1 1952  
Application for plugging filed 11-1 1952  
Application for plugging approved 11-1 1952  
Plugging commenced 11-18:00 A.M. 1952  
Plugging completed 11-14:00 P.M. 1952  
Reason for abandonment of well or producing formation --

NORTH

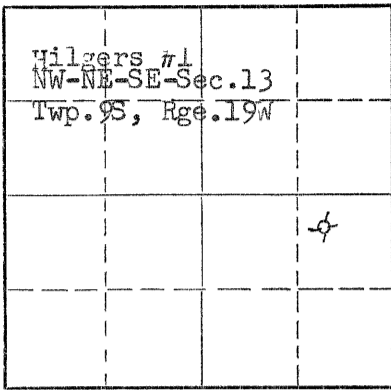

Locate well correctly on above Section Plat

If a producing well is abandoned, date of last production 19  
Was permission obtained from the Conservation Division or its agents before plugging was commenced? yes, verbal

Name of Conservation Agent who supervised plugging of this well Eldon Petty  
Producing formation Depth to top Bottom Total Depth of Well 3605 Feet  
Show depth and thickness of all water, oil and gas formations.

OIL, GAS OR WATER RECORDS

CASING RECORD

FORMATION	CONTENT	FROM	TO	SIZE	PUT IN	PULLED OUT
Post rock & Shale		0	185'		8-5/8"	none
Anhydrite		1532	3342			
Base K.C.		3556	3582			
Total Depth		3605				

Describe in detail the manner in which the well was plugged, indicating where the mud fluid was placed and the method or methods used in introducing it into the hole. If cement or other plugs were used, state the character of same and depth placed, from feet to feet for each plug set.

Stirred pits well, filled hole with heavy mud to 175' Set bottom wood plug Ran 1/2 hulls and 15 sacks of cement on same. Filled hole with heavy mud to 40' Ran 1/2 sack hulls and 10 sacks of cement filling hole to bottom of cellar.

RECEIVED  
STATE CORPORATION COMMISSION  
NOV 17 1952  
11-17-52  
CONSERVATION DIVISION  
Wichita, Kansas

(If additional description is necessary, use BACK of this sheet)  
Name of Plugging Contractor Strain Drilling Company  
Address Box 188, Hays, Kansas

STATE OF Kansas COUNTY OF Ellis, ss.  
T. C. Strain (employee of owner) or (owner or operator) of the above-described well, being first duly sworn on oath, says: That I have knowledge of the facts, statements, and matters herein contained and the log of the above-described well as filed and that the same are true and correct. So help me God. STRAIN DRILLING CO.

(Signature) By: T. C. Strain  
Box 188, Hays, Kansas (Address)

SUBSCRIBED AND SWORN to before me this 3rd day of November, 19 52

Mildred Schneider Notary Public.

My commission expires March 26, 1956

PLUGGING  
FILE SEC 13 T 9 R 19W  
NOV 16 1952

15-163-00598-00-00

WELL LOG

COMPANY: Jack Heintzman &  
Strain Drilling Co.

NW-NE-SE, Sec. 13  
Twp. 9S, Rge. 19W  
Rooks County, Kansas.

LOG: Hilgers #1

ELEVATION: 2145 N. B.

NOTE: All moss Rotary Drushings.

0	45 Foot Rock & Shale
45	145 Shale & Shells
145	215 Shale
215	630 Shale
630	660 Sand & Shale
660	940 Sand
940	945 LIME
945	1055 Sand
1055	1240 Sand & Shale
1240	1532 Red Bed & Shale
1532	1560 Anhydrite
1560	1570 Anhydrite
1570	1700 Shale & Shells & Redbed
1700	1955 Shale
1955	2115 Lime & Shale
2115	2260 Shale & Lime
2260	2375 Shale & Lime
2375	2455 Shale & Lime
2455	2535 Shale & Lime
2535	2595 Lime
2595	2715 Shale & Lime
2715	2840 Shale & Lime
2840	2980 Shale
2980	3090 Shale
3090	3150 Shale & Lime
3150	3210 Shale & Lime
3210	3260 Lime & Shale
3260	3315 Lime & Shale
3315	3350 Lime
3350	3390 Lime

3390	3410 Lime
3440	3465 Lime
3465	3488 Lime
3488	3485 Lime
3485	3540 Lime
3540	3595 Lime & Shale
3595	3605 Shale & Lime
3605	( Total Depth )

COMMENCED: 10-22-52  
COMPLETED: 11-1-52

Casing Record:

8 5/8 Surface Casing set at 185' w/100  
macks of cement by Sun Cementing Co.

No Electric Log Run

Geologist:

Hub Armstrong.

TOPS:

Geologist Tops

Anhydrite	1532	T. D. 3605-1460	Lensing	3342
Topeka	3089		Base K. C.	3556
Hachnar	3302		Shaley Cong.	3582
Toronto	3323			

STATE OF KANSAS) SS  
COUNTY OF ELLIS)

I hereby affirm that the above and foregoing is a true and correct  
copy of the log of the Hilgers #1, located NW-NE-SE, Sec. 13, Twp 9S, Rge. 19W  
Rooks County, Kansas.

CONTRACTOR: Strain Drilling Company

BY *T. C. Strain*  
T. C. Strain

Subscribed and sworn to before me this 3rd day of November 1952.  
My commission expires March 26, 1956.

Notary Public

*Mildred Schneider*

PLUGGING  
FILE SEC 13 T 9 R 19W  
PAGE 57 LINE 16