

STATE OF KANSAS  
STATE CORPORATION COMMISSION


WELL PLUGGING RECORD

OR

FORMATION PLUGGING RECORD

Strike out upper line when reporting plugging of formations.

Give All Information Completely  
Make Required Affidavit  
Mail or Deliver Report to:  
Conservation Division  
State Corporation Commission  
800 Bittling Building  
Wichita, Kansas

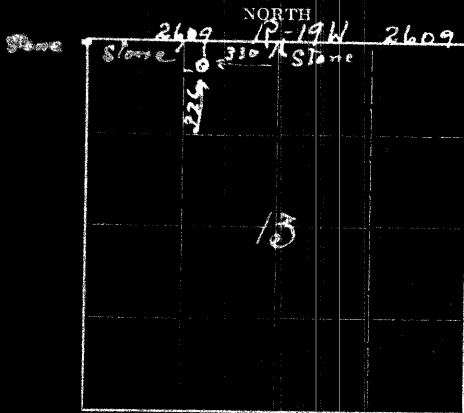

Locate well correctly on above Section Plat

Rocks..... County. Sec. 13 Twp. 9 Rge. 19 (E) (W)  
Location as "NE1/4NW1/4SW1/4" or footage from lines.....  
Lease Owner..... M. N. Bartlett  
Lease Name..... Thy fault..... Well No. 1  
Office Address..... Petroleum Building, Wichita, Kansas  
Character of Well (completed as Oil, Gas or Dry Hole)..... dry  
Date well completed..... Dec. 28, 1945..... 19. 45  
Application for plugging filed..... Dec. 28, 1945..... 19. 45  
Application for plugging approved..... Dec. 28,..... 19. 45  
Plugging commenced..... Dec. 28..... 19. 45  
Plugging completed..... Dec. 28..... 19. 45  
Reason for abandonment of well or producing formation..... dry hole

If a producing well is abandoned, date of last production..... 19.....  
Was permission obtained from the Conservation Division or its agents before plugging was commenced?..... yes

Name of Conservation Agent who supervised plugging of this well..... Mr. Herr, Great Bend, Kansas  
Producing formation..... dry..... Depth to top..... dry..... Bottom..... Total Depth of Well..... 3635..... Feet

Show depth and thickness of all water, oil and gas formations.

OIL, GAS OR WATER RECORDS

CASING RECORD

Formation	Content	From	To	Size	Put In	Pulled Out
				10 3/4	240 ft.	dry hole none

Describe in detail the manner in which the well was plugged, indicating where the mud fluid was placed and the method or methods used in introducing it into the hole. If cement or other plugs were used, state the character of same and depth placed, from..... no..... feet to..... feet for each plug set.

Hallsburton plug, pushed to two hundred and thirty-five foot, with drill pipe. Fifteen sacks of cement, on top of plug, fifteen sacks of cement in top of service pipe. Surface pipe cut off two feet below surface. Hole was filled with thirty-eight vis. mod, before plugging.

Surface pipe record

10 3/4 spiral well 28 rounds, grade A, set at 240 foot, cemented with a hundred and seventy sacks, regular cement. Cement circulated, set 48 hours.

(If additional description is necessary, use BACK of this sheet)

Correspondence regarding this well should be addressed to..... M. N. Bartlett  
Address..... Petroleum Building, Wichita, Kansas

STATE OF Kansas COUNTY OF Rocks, ss.


being first duly sworn on oath, says: That I have knowledge of the facts, statements, and matters herein contained and the log of the above-described well as filed and that the same are true and correct. So help me God.

(Signature) *E. S. Thornton*  
Plauville Kans  
(Address)

day of January 1946

*A. L. Burkholder*

Notary Public.

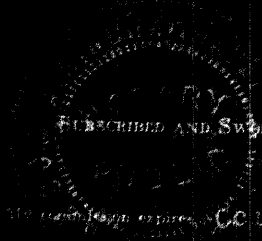

WELL LOGW. H. BARTLETTThyfault #1

The following log is of your Thyfault #1,  
described as Center of NW/4, NE/4, SW/4 of  
Section 13, Township 9 S, Range 19 W,  
Rooks County, Kansas

<u>FORMATION</u>	<u>FROM</u>	<u>TO</u>
Shale & Sand	0	260
Set: 240' of 10 3/4" Surface pipe		
Shale & Shells	260	970
Sand	970	1110
Shale & Shells	1110	1455
Anhydrite	1455	1495
Shale & Shells	1495	2050
Lime & Shells	2050	2150
Shale & Shells	2150	2235
Lime & Shells	2235	2529
Lime	2529	2554
Shale & Lime	2554	3171
Lime	3171	3185
Shale	3185	3200
Lime & Shell	3200	3230
Lime	3230	3247
Lime & Shale	3247	3285
Lime	3285	3563
Chert	3563	3570
Lime	3570	3575
Chert	3575	3580
Shale	3580	3593
Shale & Lime	3593	3635
Total Depth:	3635'	

13 9 1940  
39 10

JAN 14 1946  
1-14-46

I, the undersigned, being first duly sworn upon oath, state that this well record is true, correct and complete according to the records of this office and to the best of my knowledge and belief.

A. M. French  
A. M. French

Subscribed and sworn to before me this 31st day of Dec. 1945.

My commission expires Oct. 14, 1949 Art W. Sumpster  
Notary Public