


STATE OF KANSAS
STATE CORPORATION COMMISSION

Give All Information Completely
Make Required Affidavit
Mail or Deliver Report to:
Conservation Division
State Corporation Commission
211 No. Broadway
Wichita, Kansas

WELL PLUGGING RECORD

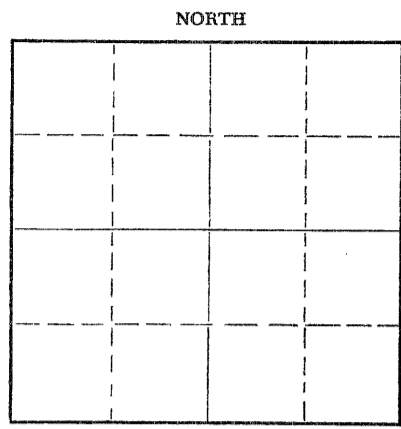

Rooks _____ County. Sec. 11 Twp. 9 Rge. (E) 20 (W)
Location as "NE/CNW/SW" or footage from lines SE NE NW
Lease Owner Jones, Shelburne & Farmer, Inc.
Lease Name BALDWIN B Well No. 3
Office Address Russell, Kansas
Character of Well (completed as Oil, Gas or Dry Hole) Dry
Date well completed 2/10 19 57
Application for plugging filed 2/10 19 57
Application for plugging approved 2/10 19 57
Plugging commenced 2/10 19 57
Plugging completed 2/10 19 57
Reason for abandonment of well or producing formation Dry

If a producing well is abandoned, date of last production _____ 19____
Was permission obtained from the Conservation Division or its agents before plugging was commenced? Yes

Name of Conservation Agent who supervised plugging of this well Eldon Petty
Producing formation _____ Depth to top _____ Bottom _____ Total Depth of Well 3695 Feet
Show depth and thickness of all water, oil and gas formations.


OIL, GAS OR WATER RECORDS

CASING RECORD

FORMATION	CONTENT	FROM	TO	SIZE	PUT IN	PULLED OUT
				80		
				8-5/8	160	None

Describe in detail the manner in which the well was plugged, indicating where the mud fluid was placed and the method or methods used in introducing it into the hole. If cement or other plugs were used, state the character of same and depth placed, from _____ feet to _____ feet for each plug set.

1. Filled hole with heavy mud
2. Pushed plug to 160
3. Dumped in 1/2 sack hulls on top of plug
4. Mixed 15 sacks cement and dumped on top of hulls
5. Filled hole to top
6. Pushed plug to 40
7. Dumped 1/2 sacks hulls
8. Mixed 10 sacks cement and filled hole to top with same.

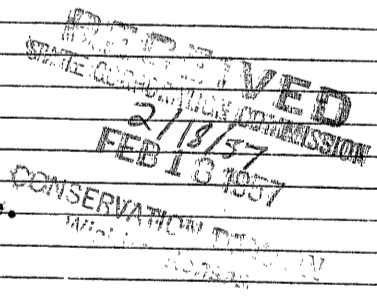


(If additional description is necessary, use BACK of this sheet)
Name of Plugging Contractor Jones, Shelburne & Farmer, Inc.
Address Russell, Kansas

STATE OF Kansas, COUNTY OF Russell, ss.
JOHN O. FARMER (owner or operator) of the above-described well, being first duly sworn on oath, says: That I have knowledge of the facts, statements, and matters herein contained and the log of the above-described well as filed and that the same are true and correct. So help me God.

(Signature) John O. Farmer
Russell, Kansas
(Address)

SUBSCRIBED AND SWORN TO before me this 12th day of February, 19 57

My commission expires 10/11/58
Lucille Kennedy Notary Public.

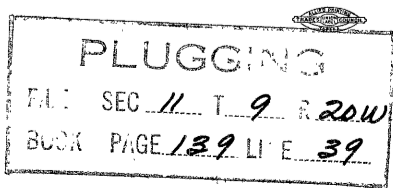

OPERATOR Jones, Shelburne & Farmer, Inc.ADDRESS Russell, Kansas

15-163-025 08-00-00

FORMATION RECORD

Give detailed description and thickness of all formations drilled through, contents of sand, whether dry, water, oil or gas.

Formation	Top	Bottom	Formation	Top	Bottom
Surface	0	160			
Shale	160	800			
Shale & sand	800	1120			
Sand	1120	1365			
Redbed	1365	1633			
Anhydrite	1633	1677			
Shale & shells	1677	2150			
Lime & shale	2150	3390			
Lime	3390	3595			
Lime & shale	3595	3640			
Conglomerate	3640	3661			
Arbuckle	3661	3695			
T.D.		3695			

SAMPLE TOPS:


Elevation RB	2142
Anhydrite	1633
Heebner	3340
Toronto	3361
Lansing	3381
B/Kansas City	3597
Conglomerate	3639
Arbuckle	3661
T.D.	3695
D & A	

PLUGGING
 SEC. 11, T. 9, R. 20W
 PAGE 139 LINE 39

I, the undersigned, being first duly sworn upon oath, state that this well record is true, correct and complete according to the records of this office and to the best of my knowledge and belief.

John W. Farmer Vice-Pres.
 Name and title of representative of company

Subscribed and sworn to before me this 12th day of February, 19 57
 My Commission expires 10/11/58
Lucille Kennedy
 Notary Public

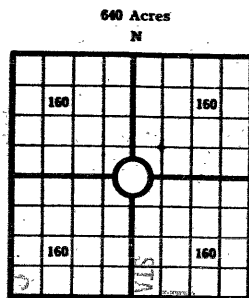

Locate well correctly

COUNTY Rooks SEC. 11 TWP. 9 RGE 20
 COMPANY OPERATING Jones, Shelburne & Farmer, Inc.
 OFFICE ADDRESS Russell, Kansas
 FARM NAME BALDWIN B WELL NO. 3
 DRILLING STARTED 2-1, 19 57 DRILLING FINISHED 2-10, 19 57
 DATE OF FIRST PRODUCTION _____ COMPLETED _____
 WELL LOCATED SE 1/4 NE 1/4 NW 1/4 North of South
 Line and _____ ft. East of West Line of Quarter Section
 Elevation (Relative to sea level) DERRICK FLOOR 2140 GROUND 2137
 CHARACTER OF WELL (Oil, gas or dryhole) Dry

OIL OR GAS SANDS OR ZONES

Name	From	To	Name	From	To
			4		
			5		
			6		

Perforating Record If Any

Shot Record

Formation	From	To	No. of Shots	Formation	From	To	Size of Shot

CASING RECORD

Amount Set								Amount Pulled		Packer Record	
Size	Wt.	Thds.	Make	Ft.	In.	Ft.	In.	Size	Length	Depth Set	Make
8-5/8				160							

Liner Record: Amount _____ Kind _____ Top _____ Bottom _____

CEMENTING AND MUDDING

Size	Amount Set		Sacks Cement	Chemical		Method of Cementing	Amount	Mudding Method	Results (See Note)
	Ft.	In.		Gal.	Make				
85/8	160		100						

Note: What method was used to protect sands if outer strings were pulled? _____

NOTE: Were bottom hole plugs used? _____ If so, state kind, depth set and results obtained _____

TOOLS USED

Rotary Tools were used from _____ feet to _____ Cable tools were used from _____ feet to _____
 feet, and from _____ feet to _____ feet, and from _____ feet to _____

Type Rig _____

INITIAL PRODUCTION TEST

Describe initial test: whether by flow through tubing or casing or by pumping _____

Amount of Oil Production _____ bbls. Size of choke, if any _____ Length of test _____ Water
 Production _____ bbls. Gravity of oil _____ Type of Pump if pump is used, describe _____

FARM NAME BALDWIN B
 WELL NO. 3
 COUNTY Rooks
 SEC. 11
 TWP. 9
 RGE. 20